

JONES MISSISSIPPI BOARD OF WATER

D 54
10-11-61

D 38 USGS USG
WATER WELL DRILLERS LOG

Date: 10/11, 1961, Driller: ~~H. H. P. Clark~~ P. Clark County Jones
(Name)


(1) Owner of Land: Humble Oil Co
Laurel, Miss
(Name)
(Address)
(2) Location: 1/4, 1/4, Sec. 12 T7 R10W
6 miles East of Janelorville
(distance) (direction) (Nearest Town)
(3) Topography: (Hilly) (Flat) (Level)
(4) Purpose of Well: Office
(Domestic, Irrigation, Municipal, Industrial, Other)

Description & Color of Materials Sand, Clay, Red Clay, Shell, etc.	Thick- ness Feet	Depth Feet
0-10 red clay	10	10
10-25 red sand	15	25
25-68 Blue Clay	43	68
68-80 Blue sand	12	80

Information upon completion of well:

(1) Diameter 2 inches.
(2) Total Depth 80 feet.
(3) Water Level 65 feet below top of ground.
(4) Cased to 10, Size 2 in
(5) Screen: Size 1/4, Length 10
(6) Were any formations sealed against pollution?
 yes, no.

If YES depth of formation 42
Why: Keep surface water from entering well
Drillers Remarks: Well located at Harris McFarland tank battery Bryan oil field

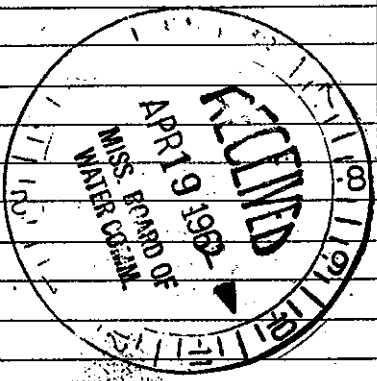

(Use Back Side)

Well No.

Mail this copy to Board of Water Commissioners 429 Miss. St. Jackson, Miss.