

JONES MISSISSIPPI BOARD OF WATER COMMISSIONERS

D 45 VSGS. file  
 1-8-62 WATER WELL DRILLERS LOG

Date Jan 8, 1962, Driller Robert E. Ruffin Co. County Jones (Name)

(1) Owner of Land: Jones of Sundersville  
 (Name)  
Sundersville, Miss.  
 (Address)

(2) Location: 1/4, 1/4, Sec. 1 T. 1 R. 1  
1 miles, of 1 miles  
 (distance) (direction) (Nearest Town)

(3) Topography: \_\_\_\_\_  
 (Hilly) (Flat) (Level)

(4) Purpose of Well: Municipal  
 (Domestic Irrigation, Municipal, Industrial, Other)

Description & Color of Materials Sand, Clay, Red Clay, Shell, etc.	Thick- ness Feet	Depth Feet
Clay	0	15
Sand	15	34
Clay	34	79
Sand	79	89
Shale	89	178
Rock	178	179
Sand	179	180
Shale	180	210
Rock	210	212
Shale	212	227
Rock	227	228
Shale	228	258
Rock	258	259
Shale	259	261
Rock	261	262
Shale	262	269
Hard Rock	269	293
Shale	293	303
Rock	303	305
Sand	305	325
Rock	325	327
Sandy Shale	327	360
Blue Shale	360	607
Rock	607	609
Shale	609	671
Sand	671	708
fine Sand	708	730
Shale	730	760
Sandy Shale	760	790
Hard Shale	790	804


Information upon completion of well:

- (1) Diameter 8 inches.
- (2) Total Depth 710 feet.
- (3) Water Level \_\_\_\_\_ feet below top of ground.
- (4) Cased to 670, Size 8"
- (5) Screen: Size 4", Length 40'
- (6) Were any formations sealed against pollution?  
 yes, \_\_\_\_\_ no.

If YES depth of formation \_\_\_\_\_

Why \_\_\_\_\_

Drillers Remarks: \_\_\_\_\_

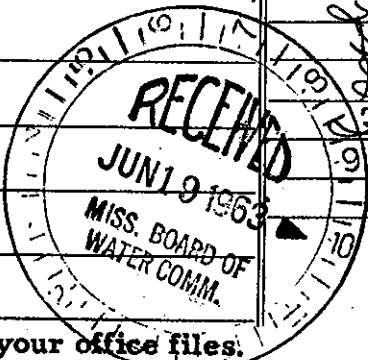

(Use Back Side)

Well No.

Retain this copy for your office files.