

JONES  
D 48

MISSISSIPPI BOARD OF WATER COMMISSIONERS

WATER WELL DRILLERS LOG  
WATER WELL DRILLING

2  
Cote 6 ✓  
Jones

10-1-60

Date: 10/1, 1960, Driller: LAUREL, MISS. County: Jones

(1) Owner of Land: Mrs. Leona Reynolds  
(Name)  
Rt 6 Laurel, Miss  
(Address)

(2) Location: 1/4, 1/4, Sec. 36 N 10 W R  
1.2 miles East of Laurel  
(distance) (direction) (Nearest Town)

(3) Topography: X  
(Hill) (Flat) (Level)

(4) Purpose of Well: Dairy + Home  
(Domestic Irrigation  
Municipal, Industrial, Other)

Description & Color of Materials Sand, Clay, Red Clay, Shell, etc.	Thick- ness Feet	Depth Feet
0-80 Clay	80	
80-150 Sand	70	
150-180 Clay	30	
180-215 Sand	35	
215-230 Clay	15	
230-242 Sand	12	
242-290 Hard Clay	48	
290-294 Rock	4	
294-348 Rock + Hard Clay	54	
348-450 Hard Clay		
Sea Shells	102	


Information upon completion of well:

- (1) Diameter 2 inches.
- (2) Total Depth 450 feet.
- (3) Water Level 52 feet below top of ground.
- (4) Cased to 292, Size 2
- (5) Screen: Size None, length
- (6) Were any formations sealed against pollution?  
yes, no.

If YES depth of formation 291 + 290

Why This well was made

Drillers Remarks: open end water coming from Honeycomb pine rocks, to obtain better quality of water

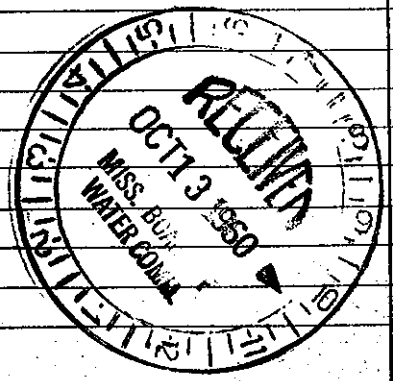

(Use Back Side)

Well No.

Mail this copy to Board of Water Commissioners 429 Miss. St. Jackson, Miss