

JONES MISSISSIPPI BOARD OF WATER COMMISSIONERS

D 49
10-3-60

Case 6
WATER WELL DRILLERS LOG

Dec 14

Date: 10/3, 1960, Driller: C.P. Clark County Jones
(Name)

(1) Owner of Land:	Description & Color of Materials Sand, Clay, Red Clay, Shell, etc.	Thick- ness Feet	Depth Feet
<u>Grady Pushton</u> (Name)	<u>0-40 Clay</u>	<u>40</u>	
<u>Rt # 2 Laurel, Miss</u> (Address)	<u>40-51 Sandy Clay</u>	<u>11</u>	
(2) Location: <u>1/4, 1/4, Sec 21 19^N R10^W</u>	<u>51-95 Clay</u>	<u>44</u>	
<u>6 miles East of Laurel</u> (distance) (direction) (Nearest Town)	<u>95-118 Sand</u>	<u>23</u>	
(3) Topography: <u>X</u> (Hilly) (Flat) (Level)	<u>118-150 Clay</u>	<u>32</u>	
(4) Purpose of Well: <u>Domestic Irrigation</u> Municipal, Industrial, Other)	<u>150-190 Sandy Clay</u>	<u>40</u>	
	<u>190-212 Sand</u>	<u>22</u>	


Information upon completion of well:

- (1) Diameter 2 inches.
- (2) Total Depth 212 feet.
- (3) Water Level 42 feet below top of ground.
- (4) Cased to 202, Size 2.
- (5) Screen: Size 1 1/4, Length 10.
- (6) Were any formations sealed against pollution?
_____ yes, no.

If YES depth of formation _____

Why _____

Drillers Remarks: Go Hwy 84 East to Dunigons Gro turn left on Blacktop Go 1 mile North

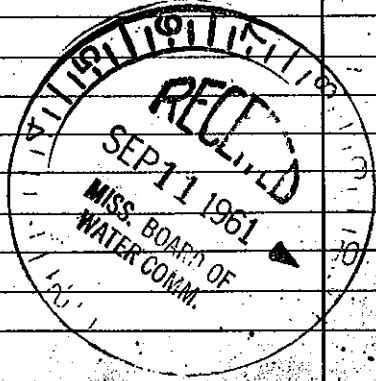

(Use Back Side)

Mail this copy to Board of Water Commissioners 429 Miss. St. Jackson, Miss.