

D 50  
10-8-60

**WATER WELL DRILLERS LOG**  
C. P. CLARK

Date: 10/8, 1960, Driller: WATER WELL DRILLING County Jones  
ROUTE TWO  
LAUREL, MISS.

(1) Owner of Land:	Description & Color of Materials Sand, Clay, Red Clay, Shell, etc.	Thick- ness Feet	Depth Feet
<u>Harold Galtin</u> (Name) <u>Sandersville Miss</u> (Address)	<u>0-50 Clay</u>	<u>50</u>	
(2) Location: <u>1/4</u> , <u>1/4</u> , Sec. <u>32</u> <u>T10N R10W</u> <u>1/4</u> miles <u>East</u> , of <u>Sandersville</u> (distance) (direction) (Nearest Town)	<u>50-52 Sand</u>	<u>2</u>	
(3) Topography: <u>X</u> (Hilly) (Flat) (Level)	<u>52-201 Clay</u>	<u>149</u>	
(4) Purpose of Well: <u>✓</u> (Domestic Irrigation Municipal, Industrial, Other)	<u>201-216 Fine Sand</u>	<u>15</u>	


Information upon completion of well:

- (1) Diameter 2 inches.
- (2) Total Depth 216 feet.
- (3) Water Level 54 feet below top of ground.
- (4) Cased to 204, Size 2
- (5) Screen: Size 1 1/4, Length 12
- (6) Were any formations sealed against pollution?  
\_\_\_\_\_ yes, ✓ no.

If YES depth of formation \_\_\_\_\_

Why \_\_\_\_\_

Drillers Remarks: \_\_\_\_\_

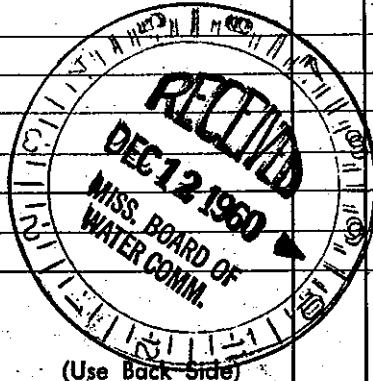

Well No. \_\_\_\_\_