

JONES

MISSISSIPPI BOARD OF WATER COMMISSIONERS

D

52

✓ D 300

WATER WELL DRILLERS LOG

12-3-60

Date: 12-3, 1960, Driller: H.H. Boler, County: Jones

(Name)

(1) Owner of Land:	Description & Color of Materials Sand, Clay, Red Clay, Shell, etc.	Thick- ness Feet	Depth Feet
E.L. Fairbrough (Name) Sardenville Miss (Address)	Red sand	30	
	Gray clay	12	
	Sand	24	
(2) Location: 1/4, 1/4, Sec. 36 T10N R10E 5 miles East, Sardenville (distance) (direction) (Nearest Town)			66
(3) Topography: <input checked="" type="checkbox"/> (Hilly) <input type="checkbox"/> (Flat) <input type="checkbox"/> (Level)			
(4) Purpose of Well: Home (Domestic Irrigation, Municipal, Industrial, Other)			

Information upon completion of well:

(1) Diameter 2 inches.

(2) Total Depth 66 feet.

(3) Water Level 40 feet below top of ground.

(4) Cased to 60, Size 2"


(5) Screen: Size 1/4, Length 6 ft

(6) Were any formations sealed against pollution?
 yes, no.

If YES depth of formation _____

Why _____

Drillers Remarks: _____

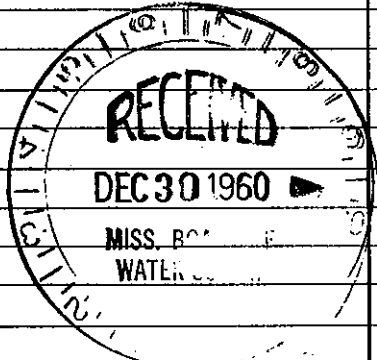

Well No.

(Use Back Side)

Mail this copy to Board of Water Commissioners 429 Miss. St. Jackson, Miss.