

JONES MISSISSIPPI BOARD OF WATER COMMISSIONERS

D 53
8-26-61

WATER WELL DRILLERS LOG

Date: 8/26, 1961, Driller: C. P. Clark County: Jones
(Name)


(1) Owner of Land:	Description & Color of Materials Sand, Clay, Red Clay, Shell, etc.	Thick- ness Feet	Depth Feet
<u>Olmo Howard</u> (Name)	<u>0-9 Clay</u>	<u>9</u>	
<u>Sandersville Miss</u> (Address)	<u>9-26 Water Sand</u>	<u>17</u>	
(2) Location: <u>1/4</u> , <u>1/4</u> , Sec. <u>5</u> T. <u>9N</u> R. <u>10W</u>	<u>26-197 Blue Clay</u>	<u>171</u>	
_____ miles _____ of <u>Sandersville</u>	<u>197-320 Rock + Blue Clay</u>	<u>125</u>	
(distance) (direction) (Nearest Town)	<u>320-648 Blue Clay</u>	<u>328</u>	
(3) Topography: _____	<u>648-680 Sand & Shells</u>	<u>32</u>	
(Hilly) (Flat) (Level)	<u>680-760 Blue Sand</u>	<u>80</u>	
(4) Purpose of Well: <u>Domestic</u>	<u>760-810 Brown Sand</u>	<u>50</u>	
(Domestic Irrigation Municipal, Industrial, Other)	<u>810-830 Sandy Clay</u>	<u>20</u>	
	<u>830-843 Blue Clay</u>	<u>13</u>	

Information upon completion of well:

- (1) Diameter 2 inches.
- (2) Total Depth 774 feet.
- (3) Water Level 65 feet below top of ground.
- (4) Cased to 736, Size 2 in
- (5) Screen: Size 1/4, Length 38 ft
- (6) Were any formations sealed against pollution?
 yes, _____ no.

If YES depth of formation 635

Why _____
Drillers Remarks: Well located in Sandersville Miss Standard Sta.

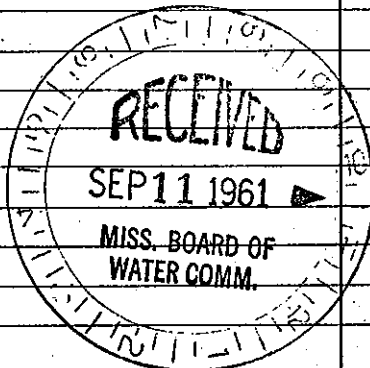

(Use Back Side)

Well No.