

JONES MISSISSIPPI BOARD OF WATER COMMISSIONERS

D 53

1-8-62

6 WATER WELL DRILLERS LOG

Date: 1/8, 1962, Driller: C.P. Clark County Jones

(Name)

(1) Owner of Land: D.F. Walters  
 (Name)  
Rt #1 Laurel Miss.  
 (Address)

(2) Location: 1/4, 1/4, Sec. 31, T9N, R10E  
5 miles East of Laurel  
 (distance) (direction) (Nearest Town)

(3) Topography: Domestic  
 (Hilly) (Flat) (Level)

(4) Purpose of Well: Domestic  
 (Domestic Irrigation, Municipal, Industrial, Other)

Description & Color of Materials Sand, Clay, Red Clay, Shell, etc.	Thick- ness Feet	Depth Feet
0-10 Red Clay	10	10
10-92 Gray Clay	82	92
92-120 White Sand	28	120

Information upon completion of well:

(1) Diameter 2 inches.

(2) Total Depth 120 feet.

(3) Water Level 10 feet below top of ground.

(4) Cased to 114, Size 2


(5) Screen: Size 1/4, Length 6ft

(6) Were any formations sealed against pollution?  
 yes,  no.

If YES depth of formation \_\_\_\_\_

Why \_\_\_\_\_

Drillers Remarks: \_\_\_\_\_

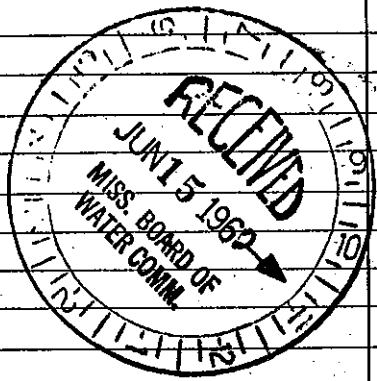

Well No.

(Use Back Side)

Mail this copy to Board of Water Commissioners 429 Miss. St. Jackson, Miss.