

JONES

MISSISSIPPI BOARD OF WATER COMMISSIONERS

D 57
4-9-62

WATER WELL DRILLERS LOG

Date: 4/9, 1962, Driller: C.P. Clark County: Jones

(Name)

(1) Owner of Land:	Description & Color of Materials Sand, Clay, Red Clay, Shell, etc.	Thick- ness Feet	Depth Feet
Dow Crocker (Name) Rt 6 Laurel Miss. (Address)	0-12 Sandy Clay	12	
(2) Location: 1/4, 1/4, Sec 33, T 2 R 10 W	12-65 Yellow Sand	53	
6 miles East of Laurel (distance) (direction) (Nearest Town)			
(3) Topography: <input checked="" type="checkbox"/> (Hilly) <input type="checkbox"/> (Flat) <input type="checkbox"/> (Level)			
(4) Purpose of Well: <input checked="" type="checkbox"/> Domestic, Irrigation <input type="checkbox"/> Municipal, Industrial, Other			


Information upon completion of well:

- (1) Diameter 2 inches.
- (2) Total Depth 65 feet.
- (3) Water level 34 feet below top of ground.
- (4) Cased to 59, Size 2
- (5) Screen: Size 1 1/4, Length 6
- (6) Were any formations sealed against pollution?
_____ yes, no.

If YES depth of formation _____

Why _____

Drillers Remarks: _____

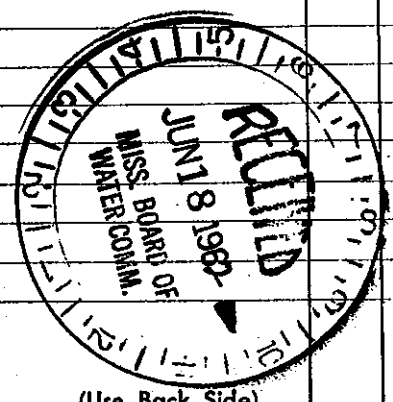

(Use Back Side)

Well No.

Mail this copy to Board of Water Commissioners 429 Miss. St. Jackson, Miss