

JONES

MISSISSIPPI BOARD OF WATER COMMISSIONERS

D 59

6

WATER WELL DRILLERS LOG

7-5-62

Date: 7/5, 1962, Driller: G.P. Clark County Jones

(Name)


(1) Owner of Land:	Description & Color of Materials Sand, Clay, Red Clay, Shell, etc.	Thick- ness Feet	Depth Feet
Nolan Windham Rt #2 Heidelberg Miss (Name) (Address)	0-10 yellow clay	10	
(2) Location: 1/4, 1/4, Sec. 36 T10 R10	10-32 Sand	22	
5 miles East of Sandersville	32-70 Blue Clay	38	
(3) Topography: <input checked="" type="checkbox"/> (Hilly) <input type="checkbox"/> (Flat) <input type="checkbox"/> (Level)	70-71 Rock	1	
(4) Purpose of Well: Domestic	71-112 Blue Clay	41	
	112-116 Rock	4	
	116-124 Blue Clay	8	
	124-130 Rock	6	
	130-144 Blue Clay	14	
	144-145 Rock	1	
	145-190 white Clay	45	
	190-240 Blue Clay	50	

Information upon completion of well:

- (1) Diameter 2 inches.
- (2) Total Depth 240 feet.
- (3) Water Level 18 in feet below top of ground.
- (4) Cased to 114, Size 2 in
- (5) Screen: Size None, Length none
- (6) Were any formations sealed against pollution?
 yes, no.

If YES depth of formation 114
Why Seal Surface Water

Drillers Remarks:

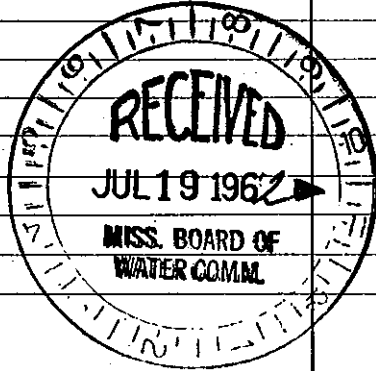

(Use Back Side)

Well No.

Mail this copy to Board of Water Commissioners 429 Miss. St. Jackson, Miss