

JONES MISSISSIPPI BOARD OF WATER COMMISSIONERS

D 60

10-10-62

WATER WELL DRILLERS LOG

Date: Oct 10, 1962, Driller: Barton Drilling & Pump Co. Wayne
(Name)

	Description & Color of Materials Sand, Clay, Red Clay, Shell, etc.	Thick- ness Feet	Depth Feet
(1) Owner of Land: <u>Hermit Lowrey</u> <small>(Name)</small>	<u>red clay</u>	<u>10</u>	<u>10</u>
<u>Rt 2 Heidelberg, Miss</u> <small>(Address)</small>	<u>course red sand</u>	<u>29</u>	<u>39</u>
(2) Location: <u>SE 1/4, SW 1/4, Sec. 36 T10R10</u>	<u>chalk & sand</u>	<u>27</u>	<u>66</u>
<u>5 miles east</u> , of <u>Sandbrill</u> <small>(distance) (direction) (Nearest Town)</small>	<u>sand with much chalk</u>	<u>13</u>	<u>79</u>
	<u>stopped on chalk</u>		
(3) Topography: <u>hilly</u> <small>(Hilly) (Flat) (Level)</small>			
(4) Purpose of Well: <u>domestic</u> <small>(Domestic Irrigation Municipal, Industrial, Other)</small>			


Information upon completion of well:

- (1) Diameter 2' inches.
- (2) Total Depth 79' feet.
- (3) Water Level 58' feet below top of ground.
- (4) Cased to 70, Size 2"
- (5) Screen: Size 1 1/4, Length 5'
- (6) Were any formations sealed against pollution?
Johnson stainless steel
_____ yes, X no.

If YES depth of formation _____

Why _____

Drillers Remarks: _____

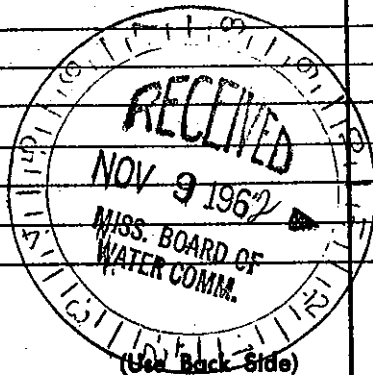

Well No.

Mail this copy to Board of Water Commissioners 429 Miss. St. Jackson, Miss.