

JONES
D 63
3-68

MISSISSIPPI
BOARD OF WATER COMMISSIONERS
416 North State Street
Jackson, Mississippi 39201

WATER WELL DRILLERS LOG


3-2-68 1968 Ray V. West Jones
date well completed firm name county well located

LANDOWNER:	description of formations encountered	from	to
<u>Joe Lewis</u>			
<u>Rt 2</u>	<u>Clay</u>	<u>0</u>	<u>20</u>
<u>Hillburg, Miss</u>	<u>soiled</u>	<u>20</u>	<u>35</u>
(mailing address)	<u>Sandy clay</u>	<u>35</u>	<u>50</u>
	<u>Sand</u>	<u>50</u>	<u>71</u>

WELL LOCATION:
sec. 9 T. 9 N. R. 10 E
8 miles E of Laud
(distance) (direction) (nearest town)

WELL PURPOSE: home
(home, irrigation, municipal, industrial)

- WELL COMPLETION DATA:
- diameter (inches) 2 in
 - total depth (feet) 71 ft
 - static water level (feet) 40 below above top of ground.
 - casing plastic, 61
(material) (depth)
(size) if telescope see back.
 - screen 10 61
(length) (depth to top)
1/4 stainless steel
(size) (material)
 - pump 1 5
(HP) (yield gpm)
Rea
(type power)
 - electric log no
(yes or no)
(organization running log)
 - how well bottom plugged was done

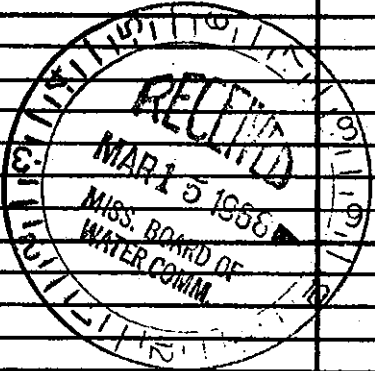

DRILLERS REMARKS: