

**JONES MISSISSIPPI BOARD OF WATER COMMISSIONERS**

Date: 9-15-64

**WATER WELL DRILLERS LOG USGS Files**

Date: 9/15, 1964, Driller: C.P. Clark County Jones  
 (Name)


(1) Owner of Land: H. S. Clark  
 (Name)  
Rt #2 Heidelberg Miss  
 (Address)  
 (2) Location: 1/4, 1/4, Sec. 36 T. 10 N. R. 10 W.  
5 miles East Sandersville  
 (distance) (direction) (Nearest Town)  
 (3) Topography: Hilly  
 (Hilly) (Flat) (Level)  
 (4) Purpose of Well: Domestic  
 (Domestic Irrigation, Municipal, Industrial, Other)

Description & Color of Materials Sand, Clay, Red Clay, Shell, etc.	Thick- ness Feet	Depth Feet
0-20 Sandy Clay	20	
20-134 Course Sand	114	
134-144 Sandy Shales	10	
144-149 Clay	05	
149-150 Rock	01	
149-160 Sand & Shells	11	
160-180 Blank Clay	20	
180-185 Sandy Clay	05	
185-192 Rock	07	
192-198 Clay & Shells	06	
198-203 Rock	05	
203-205 Clay & shells	02	
205-216 rock	11	
216-220 rock layers	04	
220-265 Clay & Sand S.	45	
265-285 Clay	20	

Information upon completion of well:

(1) Diameter 2 inches.  
 (2) Total Depth 285 feet.  
 (3) Water Level 125 feet below top of ground.  
 (4) Cased to 178, Size 2 in  
 (5) Screen: Size None, Length \_\_\_\_\_  
 (6) Were any formations sealed against pollution?  
 yes,  no.  
 If YES depth of formation 178

Why Seal surface water  
 Drillers Remarks: 145 ft 4 in  
Surface casing  
used

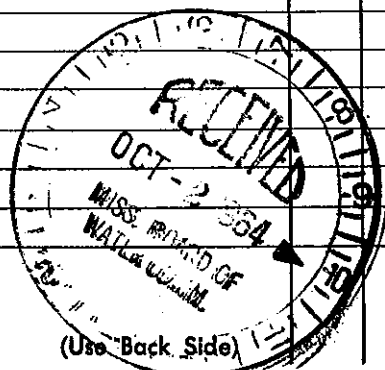

Well No.

Mail this copy to Board of Water Commissioners 429 Miss. St. Jackson, Miss.