

**JONES MISSISSIPPI BOARD OF WATER COMMISSIONERS**

D 67  
7-15-65

**WATER WELL DRILLERS LOG**

Date: 7/15, 1965, Driller: G. P. Clark County Jones  
(Name)

(1) Owner of Land:	Description & Color of Materials Sand, Clay, Red Clay, Shell, etc.	Thick- ness Feet	Depth Feet
<u>Anderson Bros Farms</u> (Name) <u>Rt #2 Laurel Miss</u> (Address)	<u>0-35 Gray Sandy</u>	<u>35</u>	
(2) Location: <u>1/4</u> , <u>1/4</u> , Sec. <u>31</u> T. <u>10</u> N. R. <u>10</u> W.	<u>35-200 ft Clay</u>	<u>165</u>	
<u>7</u> miles <u>NE</u> of <u>Laurel</u> (distance) (direction) (Nearest Town)	<u>200-251 Sand</u>	<u>51</u>	
(3) Topography: _____ (Hilly) (Flat) (Level)			
(4) Purpose of Well: <u>Chicken Farm</u> (Domestic Irrigation Municipal, Industrial, Other)			


Information upon completion of well:

- (1) Diameter 2 inches.
- (2) Total Depth 251 feet.
- (3) Water Level 142 feet below top of ground.
- (4) Cased to 246, Size 2 in.
- (5) Screen: Size 1 1/4, Length 5.55.
- (6) Were any formations sealed against pollution?  
\_\_\_\_\_ yes, \_\_\_\_\_ no.

If YES depth of formation \_\_\_\_\_

Why \_\_\_\_\_

Drillers Remarks: \_\_\_\_\_

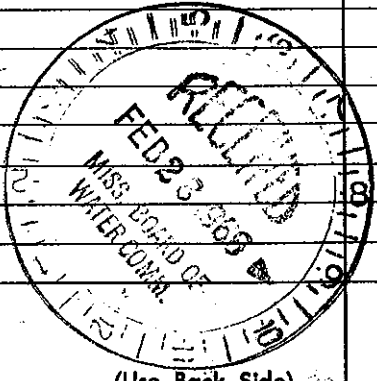

(Use Back Side)

Well No. \_\_\_\_\_

Mail this copy to Board of Water Commissioners 429 Miss. St. Jackson, Miss.