

**JONES MISSISSIPPI BOARD OF WATER COMMISSIONERS**

**D 69**  
**3-25-66**

**WATER WELL DRILLERS LOG**

Date: 3/25 1966, Driller: C. J. Clark County Jones  
(Name)

(1) Owner of Land:	Description & Color of Materials Sand, Clay, Red Clay, Shell, etc.	Thick- ness Feet	Depth Feet
<u>Lawrence Byrd</u> (Name)	<u>0-9 Red Clay</u>	<u>09</u>	
<u>Rt #6 Laurel Miss</u> (Address)	<u>9-100 Sand</u>	<u>91</u>	
(2) Location: <u>3/4</u> , <u>3/4</u> , Sec. <u>31</u> T. <u>10</u> R. <u>10</u>	<u>100-110 Sandy Clay</u>	<u>10</u>	
<u>8</u> miles <u>N-E</u> , of <u>Laurel</u> (distance) (direction) (Nearest Town)			
(3) Topography: <u>Hilly</u> (Hills) (Flats) (Level)			
(4) Purpose of Well: <u>Chicken House</u> (Domestic Irrigation Municipal, Industrial, Other)			


**Information upon completion of well:**

- (1) Diameter 2 inches.
- (2) Total Depth 100 feet.
- (3) Water Level 30 feet below top of ground.
- (4) Cased to 95, Size 2 in.
- (5) Screen: Size 1/4, Length 5.
- (6) Were any formations sealed against pollution?  
 yes,  no.

If YES depth of formation \_\_\_\_\_

Why \_\_\_\_\_

Drillers Remarks: \_\_\_\_\_

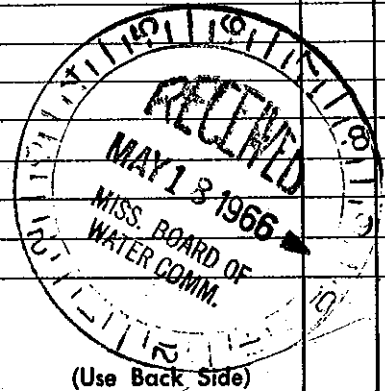

Well No. \_\_\_\_\_

Mail this copy to Board of Water Commissioners 429 Miss. St. Jackson, Miss.