

Jones
D 70

MISSISSIPPI BOARD OF WATER COMMISSIONERS

7-66

WATER WELL DRILLERS LOG

Date: 7/10, 1966, Driller: G.P. Clark County Jones

(1) Owner of Land: F.E. Rustin
Rt #6 Laurel, Miss
(Name)
(Address)

(2) Location: SE 1/4, SE 1/4, Sec. 15 T9N R10W
8 miles NE of Laurel
(distance) (direction) (Nearest Town)

(3) Topography: (Hilly) (Flat) (Level)

(4) Purpose of Well: Domestic, Irrigation, Municipal, Industrial, Other

Description & Color of Materials Sand, Clay, Red Clay, Shell, etc.	Thick- ness Feet	Depth Feet
0-20 Clay	20	
20-30 Sand	10	
30-68 Clay	38	
68-80 Sand	12	
80-95 Clay	15	
95-105 Sand	10	
105-200 Clay	95	
200-203 rock	03	
203-240 Clay	37	
240-260 Sand	20	


Information upon completion of well:

- (1) Diameter 2 inches.
- (2) Total Depth 260 feet.
- (3) Water Level 75 feet below top of ground.
- (4) Cased to 240, Size 2 in.
- (5) Screen: Size 1 1/4, Length 20.
- (6) Were any formations sealed against pollution?
 yes, no.

If YES depth of formation 232

Why Seal Surface Water

Drillers Remarks:

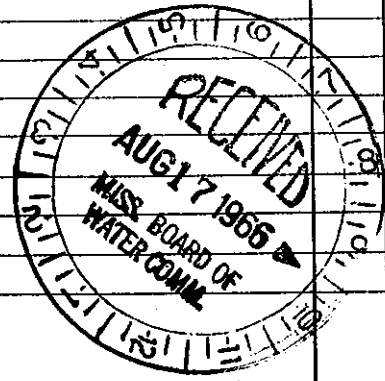

(Use Back Side)

Well No.