

Jones MISSISSIPPI BOARD OF WATER COMMISSIONERS ✓
 D 72 #1 Well South Side
 10-66 WATER WELL DRILLERS LOG

Date: 10/19, 1966, Driller: C. P. Clark County Jones
 (Name)


(1) Owner of Land: Myrick & Millbrook
 Water as (page)
 Rt #1 Laurel, Miss
 (Address) N 10
 (2) Location: S 1/4, W 1/4, Sec. 33, T. 9 N.,
 6 miles East of Laurel
 (distance) (direction) (Nearest Town)
 (3) Topography: Hilly
 (Hilly) (Flat) (Level)
 (4) Purpose of Well: Municipal
 (Domestic Irrigation
 Municipal, Industrial, Other)

Description & Color of Materials Sand, Clay, Red Clay, Shell, etc.	Thick- ness Feet	Depth Feet
25 Sandy Clay	25	25
Grey Clay	20	45
Yellow Sand	44	89
Clay	16	115
Sand	25	140
Sandy Clay	10	150
Sand	30	180
Clay	7	187
Rock	6 in	187-6"
Clay	12 1/2	210
Sandy Clay	20	230
Clay	23	253
Sand + Clay streaks	14	267
Red Sand	80	347

Information upon completion of well:

- (1) Diameter 6 inches.
- (2) Total Depth 347 feet.
- (3) Water Level 115 feet below top of ground.
- (4) Cased to 272, Size 6 in
- (5) Screen: Size 4 in, Length 30 ft
- (6) Were any formations sealed against pollution?
 yes, no.

If YES depth of formation Cement Casing
 Why to 272 Seal Surface
 Water
 Drillers Remarks:

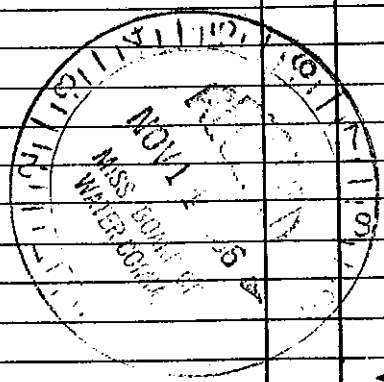

(Use Back Side)

Well No. ①