

Jones
D 73
11-66

MISSISSIPPI BOARD OF WATER COMMISSIONERS

Well #2 North Side of Lot
WATER WELL DRILLERS LOG

Date: 11/2, 19 66 Driller: C.P. Clark County Jones
(Name)


(1) Owner of Land:	Description & Color of Materials	Thick-ness Feet	Depth Feet
Mypink + Miller	Sand, Clay, Red Clay, Shell, etc.		
Water #1 Laurel Miss	Sandy Clay	7	7
(Address)	Grey Silty Clay	22	30
(2) Location: 3/4, W 1/4, Sec. 38, T. 9 N, R. 10 W	Blue Clay	19	49
6 miles East of Laurel	Yellow Sand	37	86
(distance) (direction) (Nearest Town)	Hard Clay	14	104
(3) Topography: Hilly	Sandy Clay	83	187
(Hilly) (Flat) (Level)	Clay	23	210
(4) Purpose of Well: Municipal	Sandy Clay	15	225
(Domestic Irrigation Municipal, Industrial, Other)	Clay	28	253
	Sandy + Silty Stripes	11	264
	Good Sand	8	352

Information upon completion of well:

- (1) Diameter 6 inches.
- (2) Total Depth 352 feet.
- (3) Water Level 113 feet below top of ground.
- (4) Cased to 270, Size 6 in.
- (5) Screen: Size 4 in Length 30 ft
- (6) Were any formations sealed against pollution?
 yes, no.

If YES depth of formation 270 ft
Why Seal Surface Water

Drillers Remarks:

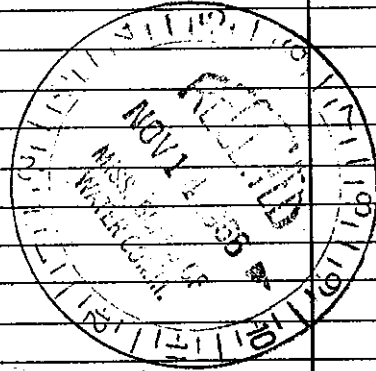

(Use Back Side)

Well No.