

Jones
D 75
9-67

MISSISSIPPI
BOARD OF WATER COMMISSIONERS
416 North State Street
Jackson, Mississippi 39201

WATER WELL DRILLERS LOG


9.9 1967 Ray West Jones
date well completed firm name county well located

LANDOWNER:	description of formations encountered	from	to
D.W. Welch	sandy clay	1	20
Rt 6	sand	20	55
Laurie Miss	Clay	55	84
(mailing address)	sand	84	95

WELL LOCATION:
sec. 13 T 9 N R 10 E
4 miles SE of Indian Mills
(distance) (direction) (nearest town)

WELL PURPOSE: Chicken house
(home, irrigation, municipal, industrial)

- WELL COMPLETION DATA:
- (1) diameter (inches) 2
 - (2) total depth (feet) 95 ft
 - (3) static water level (feet) 39 below above top of ground.
 - (4) casing Galv 90 (material) (depth)
 - (size) If telescope see back.
 - (5) screen 5 90 (length) (depth to top)
 - 1/4 Stainless Steel (size) (material)
 - (6) pump 3/4 8 (HP) (yield gpm)
 - Rea (type power)
 - (7) electric log no (yes or no)
 - (organization running log)
 - (8) how well bottom plugged with west valve

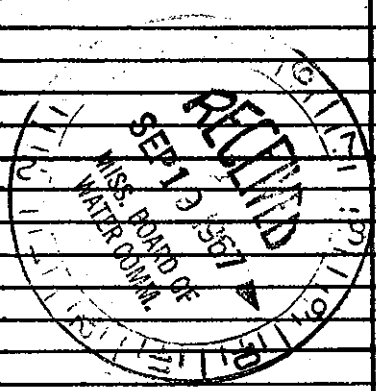

DRILLERS REMARKS: