

JASPER

MISSISSIPPI BOARD OF WATER COMMISSIONERS

Jones
~~Jones~~

W. J. Jones D77
12-5-62

WATER WELL DRILLERS LOG

Date: 12/5 1962, Driller: C.P. Clark
(BK Cadey Tank Battery) (Name) County: Jones

(1) Owner of Land: Humble Oil
Heidelberg (Name)
RT 2 Miss (Address)

(2) Location: NE 1/4, NW 1/4, Sec. 25 T19R10E
10N
5 miles N.E. of Sandersville (distance) (direction) (Nearest Town)


(3) Topography: (Hilly) (Flat) (Level)

(4) Purpose of Well:
(Domestic, Irrigation, Municipal, Industrial, Other)

Information upon completion of well:

- (1) Diameter 2 inches.
 - (2) Total Depth 602 feet.
 - (3) Water Level 110 feet below top of ground.
 - (4) Cased to 673, Size
 - (5) Screen: Size 1 1/4, Length 25
 - (6) Were any formations sealed against pollution?
yes, no.
- If YES depth of formation _____
Why _____
Drillers Remarks: _____

Description & Color of Materials Sand, Clay, Red Clay, Shell, etc.	Thick-ness Feet	Depth Feet
0-18 Red Clay	18	18
18-100 Blue Clay	82	100
100-155 Clay & Shales	55	155
155-180 Sandy Clay	25	180
180-487 Blue Clay	307	487
487-602 Clay & Shale streaks	115	602

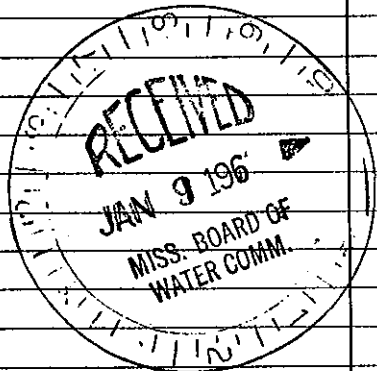

(Use Back Side)

Well No.

324800N 0573700