

C. P. CLARK
WATER WELL DRILLING
 ROUTE 2

MISSISSIPPI LAUREL, MISS. 39440
BOARD OF WATER COMMISSIONERS
 416 North State Street
 Jackson, Mississippi 39201

CODED

WATER WELL DRILLERS LOG

Jones
 D 81
 7-68

1/20 1968 *C.P. Clark* *Jones*
 date well completed firm name county well located


LANDOWNER: *John Hodge*
Box #6
Laurel Miss
 (mailing address)

WELL LOCATION:
 sec. 11 T-9^N R-10^E
 14 miles NE of Laurel
 (distance) (direction) (nearest town)

WELL PURPOSE: *Home*
 (home, irrigation, municipal, industrial)

- WELL COMPLETION DATA:
- (1) diameter (inches) 2
 - (2) total depth (feet) 140
 - (3) static water level (feet) 58 below above top of ground.
 - (4) casing Galv, 134,
 (material) (depth)
2 if telescope see back.
 (size)
 - (5) screen 6, 134
 (length) (depth to top)
1 1/4, Bronze
 (size) (material)
 - (6) pump 3/4, 7
 (HP) (yield gpm)
220V Single P.
 (type power)
 - (7) electric log no
 (yes or no)
 - (organization running log)
 - (8) how well bottom plugged BWV

description of formations encountered	from	to
<i>Sandy Clay</i>	<i>0</i>	<i>25</i>
<i>Clay</i>	<i>25</i>	<i>31</i>
<i>Sand</i>	<i>31</i>	<i>36</i>
<i>Blue Clay</i>	<i>36</i>	<i>125</i>
<i>Sand pits</i>	<i>125</i>	<i>140</i>

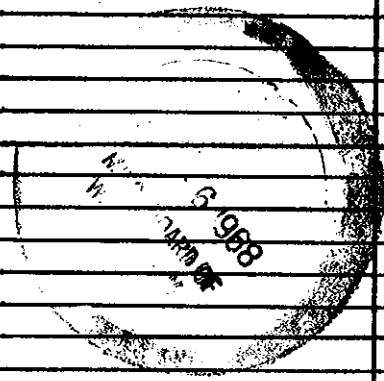

DRILLERS REMARKS: