

Jones
D 98
5-16-63

MISSISSIPPI BOARD OF WATER COMMISSIONERS

WATER WELL DRILLERS LOG

Date: 5/16, 1963, Driller: C.P. Clark ^{County} Jones
(Name)

COPIED
7/11/63


(1) Owner of Land: <u>Garland Lewis</u> (Name)	Description & Color of Materials Sand, Clay, Red Clay, Shell, etc.	Thick- ness Feet	Depth Feet
(Address) <u>26 9N10W</u>	<u>0/40 Clay</u>	<u>40</u>	
(2) Location: <u>1/4, 1/4, Sec 35, T. R.</u>	<u>40-72 yellow sand</u>	<u>32</u>	
_____ miles _____ of _____ (distance) (direction) (Nearest Town)	<u>72-108 Sandy Clay</u>	<u>36</u>	
(3) Topography: _____ (Hilly) (Flat) (Level)	<u>108-163 Sand</u>	<u>55</u>	
(4) Purpose of Well: _____ (Domestic Irrigation Municipal, Industrial, Other)	<u>163-182 Blue Sand</u>	<u>19</u>	
	<u>182-246 brown Clay</u>	<u>64</u>	
	<u>246-270 Sand</u>	<u>24</u>	

Information upon completion of well:

- (1) Diameter 2 inches.
- (2) Total Depth 270 feet.
- (3) Water Level 65 feet below top of ground.
- (4) Cased to 262, Size 2 in.
- (5) Screen: Size 1/4, Length 8 ft.
- (6) Were any formations sealed against pollution?
 yes, _____ no.

If YES depth of formation Seal top
Why Red water 231

Drillers Remarks: _____

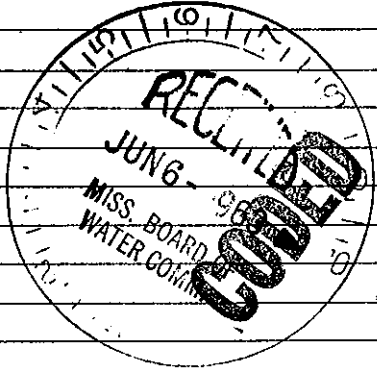

Well No.

(Use Back Side)