

MISSISSIPPI BOARD OF WATER COMMISSIONERS

Jones
D 100
5-11-63

Case # 7/1/69
JW

WATER WELL DRILLERS LOG

Date: 5/11, 1963, Driller: C.P. Clark County: Jones
(Name)


(1) Owner of Land: Hallau Martin
(Name)
Rt #1 Laurel, Miss
(Address)
36 9^N 10^W
(2) Location: 1/4, 1/4, Sec. 1 R. 13
East of Laurel
(distance) (direction) (Nearest Town)
(3) Topography: (Hilly) (Flat) (Level)
(4) Purpose of Well: Domestic
(Domestic Irrigation
Municipal, Industrial, Other)

Description & Color of Soil	Thick-ness Feet	Depth Feet
0-40 Clay	40	
40-68 Sandy Clay	28	
68-81 Sand	13	
81-140 Clay	59	
140-170 Sand	30	

Information upon completion of well:

(1) Diameter 2 inches.
(2) Total Depth 170 feet.
(3) Water Level 68 feet below top of ground.
(4) Cased to 165, Size 2 in
(5) Screen: Size 1/4, Length 5 ft
(6) Were any formations sealed against pollution?
_____ yes, no.

If YES depth of formation _____
Why _____
Drillers Remarks: _____

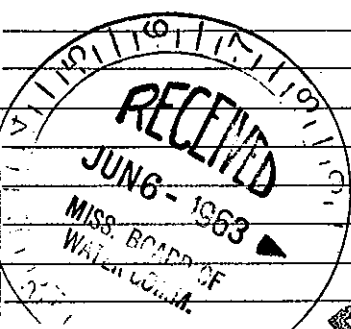

CODED

(Use Back Side)

Well No.

Mail this copy to Board of Water Commissioners 429 Miss. St. Jackson, Miss