

#4

STATE WELL REPORT

Part 1

Driller's Log

Mississippi Department of Environmental Quality
Office of Land and Water Resources
P.O. Box 2309
Jackson, MS 39225-2309
(601)961-5210
(601)360-0535 (fax)

County: Jones
Permit #:
Driller: West Water Well
Date drilling completed: 10-25-14

For Office Use Only:
Well #: D224
Aquifer:
E-Log #:

State Law requires that this report be prepared by the license holder responsible for the work and filed with the Department at the above address within 30 days of completion of drilling of the well or borehole.

Well Owner Information (Landowner if borehole is not for a water well)
Owner Name: Dean Shedd
Mailing Address: 83 Huey Shedd Rd
City: Laurel MS 39443
Telephone No. (601) 426-6730
Well or Borehole Location
Latitude: 31-44-35 Longitude: 88-58-50
Method of Lat/Long (check one): Conventional Survey
USGS quad SE 1/4 SE 1/4, Sec 15 T 9N R 10W
3 Miles SE of Sandersville

Well / Borehole Data
Date drilling started: 10-25-14 Date drilling completed: 10-25-14 Hole depth: 50 Hole diameter: 6 1/2
Location of the source of any surface water used for drilling:
Method of dosing and volume of Chlorine used in drilling and development:
Logs run (circle all applicable): No log run Electric Gamma Ray Density Sonic Neutron Other:
Name of organization running log(s):
Purpose of borehole (circle one): Water Well Geotechnical/Geological Investigation Ground Source Heat Pump
Seismic Survey Other (describe)

If drilling is not related to water well construction, skip the remainder of this block

Purpose of Well (circle all applicable): Home Industrial Public Supply Irrigation Fish Culture
Other (describe): Barn
If a flowing well, method of flow regulation: Valve Other (describe)
Static Water Level: 24 feet [above or below] land surface Date measured: 10-25-14
Method of measurement (circle one): Steel tape Electric tape Air line Other (describe)
Well depth: 50 Well grouted to a depth of: 30 feet Type of grout (circle one): Neat Cement Bentonite Mix
Casing length: 30 feet Casing diameter: 4 inches Type of casing: PVC
Screen length: 20 feet Screen diameter: 4 inches Type of screen: PVC slotted
Screen slot size: .010 inches Setting depth: From 30 feet to 50 feet
Type of completion (circle all applicable): Gravel packed Underreamed Open hole Natural Development
Other (describe):
Top of lap pipe or reduction in casing: feet

If telescoped or more than one screen, describe on next page


#4

County: Jones
 Permit #: _____

For Office Use Only:
 Well #: D224

The sketch below only required for water wells
 If well telescopes, show depths on sketch.


Description of formations encountered must be provided for all wells
 and boreholes, unless specifically exempted by regulations

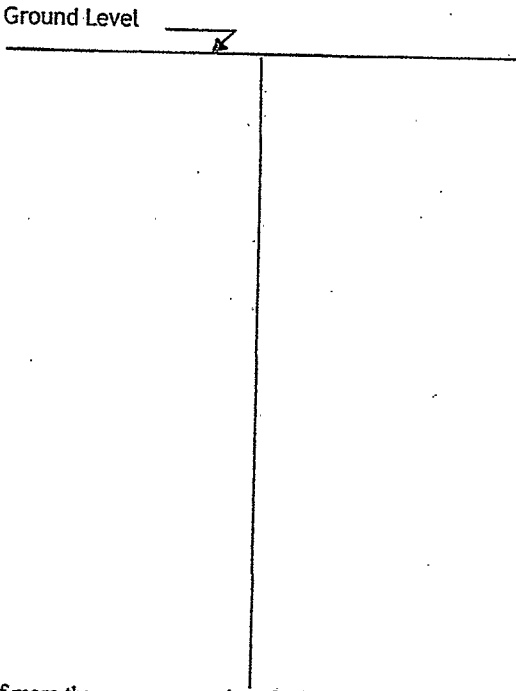

Description of Formations Encountered	From (depth) Ground level	To (depth)
CLAY		13
SAND	13	50

If more than one screen, show location of each on sketch

- Sketch the property layout and include the following:
- 1) the well location
 - 2) any permanent structures on the property that may aid in locating the well
 - 3) any roads, power lines, or other items that may aid in locating the property and the well
 - 4) north arrow

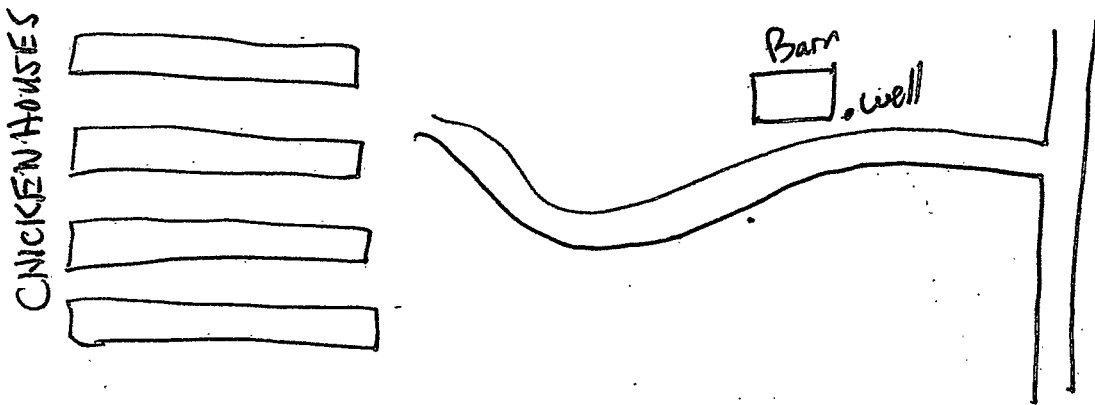

Landowner Name: Dean Shedd

I HEREBY CERTIFY that the well/borehole was drilled, constructed, and completed in accordance with all applicable requirements of the Mississippi Department of Environmental Quality and the Mississippi Department of Health regulations, if applicable, and state laws.

David A. West 0-672 4-2-17 David West
 Print Name of Responsible Licensee and License No. Date Signature of Licensee

#4

STATE WELL REPORT

Part 2

Pump Installer's Completion Report

Mississippi Department of Environmental Quality
Office of Land and Water Resources

P.O. Box 2309
Jackson, MS 39225-2309
(601)961-5210
(601) 360-0535 (fax)

For Office Use Only:

Well #: 0224

Aquifer: _____

County: Jones
 Permit #: _____
 Driller: West Water Well
 Date completed: 10-25-14
Copy information from block on Part 1

This part of the report must be completed by a licensed water well contractor, or a licensed pump installer. A copy of Part 1 of the report must be attached and both parts filed with the Department at the above address within 30 days of well completion.

Well Owner Information	Well Location
Owner Name: <u>Dean Shedd</u>	Latitude: <u>31-44-35</u> Longitude: <u>88-58-50</u>
Mailing Address: <u>83 Huey Shedd Rd</u>	Method of Lat/Long (check one): Conventional Survey _____, USGS quad _____, Hand-held GPS _____, Survey-grade GPS _____
<u>Laurel</u> <u>MS</u> <u>39443</u>	<u>SE</u> ¼ <u>SE</u> ¼, Sec <u>15</u> T <u>9N</u> R <u>10W</u>
City State Zip Code	<u>3</u> Miles <u>SE</u> of <u>Sandersville</u>
Telephone No. (<u>601</u>) <u>426-6730</u>	(Distance) (Direction) (Nearest Town)

Pump Type (circle one)
 Submersible Turbine Air Lift Centrifugal Flowing Well Jet Piston Rotary Other (describe): _____
 Date Pump Installed: 10-25-14 Rated Pump Capacity: 20 Gallons Per Minute
 Is This Pump (circle one): New Repaired Replacement

Power Type (circle one)
 Electric Diesel Gasoline Natural Gas Tractor PTO Windmill Other (describe): _____
 Horse Power Rating of Motor: 1 Setting Depth: 40 feet Number of Stages: _____

Pump Test Data for Non Flowing Well
 Date Well Tested: _____ Duration of Pump Test (minimum 4 hours): _____ hours
 Static Water Level (A): _____ Feet Below Land Surface Pumping Water Level (B): _____ Feet Below Land Surface
 Drawdown [(B) - (A)]: _____ Feet Below Land Surface Test Pumping Rate: _____ Gallons Per Minute
 Method of measurement (circle one): Steel tape Electric tape Air line Other (describe): _____

Pump Test Data for Flowing Well
 Measured shut in head: _____ feet.
 Well yielded _____ GPM with a drawdown of _____ feet after _____ hours of pumping

Meter Installation
 Meter Manufacturer: _____ Meter Serial Number: _____
 Meter Model Number/Name: _____ Type of Meter: _____
 Totalizer Register Unit and Multiplier Factor (AF x .001, gal x 1000, etc): _____
 Installation Date: _____ Meter installed by: _____
 Is This Meter (circle one): New Repaired Replacement
Important: By submitting the above information you are certifying that this meter was installed to manufacturer standards. For agricultural wells, a list of approved meters is on the MDEQ website.

I HEREBY CERTIFY that the above statements are true to the best of my knowledge.
David A. West 0672 4-2-11 David A. West
 Print Name of Pump Installer and License No. (if applicable) Date Signature of Pump Installer