

Jones
D 2000
11-3-75

MISSISSIPPI
BOARD OF WATER COMMISSIONERS
416 North State Street
Jackson, Mississippi 39201

WATER WELL DRILLERS LOG

Nov 3 1979 Ray West Water Wells Jones
date well completed firm name county well located


LANDOWNER: <u>Wiley Temple</u> <u>Rt 6</u>	description of formations encountered	from	to
		<u>Clay</u>	<u>0</u>
<u>Laurel Miss</u> (mailing address)	<u>Sandy clay</u>	<u>3</u>	<u>30</u>
	<u>Blue clay</u>	<u>30</u>	<u>98</u>
	<u>Sandy clay</u>	<u>98</u>	<u>110</u>
	<u>Rock</u>	<u>110</u>	<u>130</u>

WELL LOCATION:
sec. 12 T. 9 N. R. 16 E
9 miles N 6 of Laurel
(distance) (direction) (nearest town)

WELL PURPOSE: Home
(home, irrigation, municipal, industrial)

- WELL COMPLETION DATA:
- (1) diameter (inches) 2
 - (2) total depth (feet) 130
 - (3) static water level (feet) 75 ^{below} / above top of ground.
 - (4) casing PVC, 125
(material) (depth)
 - (size) If telescope see back.
 - (5) screen 5 125
(length) (depth to top)
 - 1/2 St Steel
(size) (material)
 - (6) pump 1 8
(HP) (yield gpm)
 - R&A
(type power)
 - (7) electric log No
(yes or no)
 - (organization running log)
 - (8) how well bottom plugged wash water

DRILLERS REMARKS:

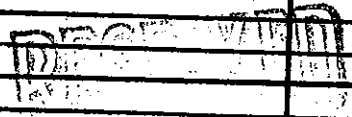

JAN 6 1976