

JONES MISSISSIPPI BOARD OF WATER COMMISSIONERS

AE6
7-25-65

WATER WELL DRILLERS LOG

Date July 25, 1965, Driller H. J. Moley County Jones
(Name)

(1) Owner of Land:	Description & Color of Materials Sand, Clay, Red Clay, Shell, etc.	Thick- ness Feet	Depth Feet
<u>Chester Smith</u> (Name) <u>Rt #1 Calhounville</u> (Address) <u>11 1/4 13th Miss</u>	<u>Chalk down</u>		
(2) Location: <u>1/4, 1/4, Sec. T. R.</u> <u>5 miles South of Jaso</u> (distance) (direction) (Nearest Town)	<u>to 95' Next</u>		
(3) Topography: _____ (Hilly) (Flat) (Level)	<u>20' fine sand</u>		
(4) Purpose of Well: _____ (Domestic Irrigation Municipal, Industrial, Other)	<u>Course sand</u>		

16 feet.


Information upon completion of well:

- (1) Diameter 2 inches.
- (2) Total Depth 141 feet.
- (3) Water Level 60 feet below top of ground.
- (4) Cased to _____, Size _____
- (5) Screen: Size 1 1/4, Length 5'
- (6) Were any formations sealed against pollution?
_____ yes, no.

If YES depth of formation _____

Why _____

Drillers Remarks: _____

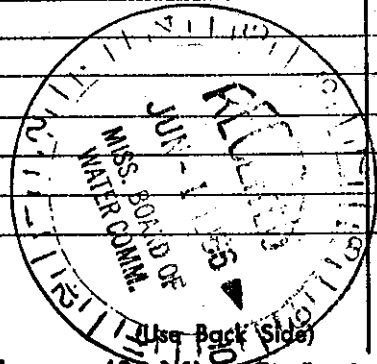

Well No. _____

Mail this copy to Board of Water Commissioners 429 Miss. St. Jackson, Miss.