


JONES

MISSISSIPPI BOARD OF WATER COMMISSIONERS

WATER WELL DRILLERS LOG

Date: 5-8, 1962, Driller: H. J. Mayby County Jones

(1) Owner of Land	Description & Color of Materials Sand, Clay, Red Clay, Shell, etc.	Thick- ness Feet	Depth Feet
Charles Evans (Name) Route #1 Ellendale, Miss (Address)			
(2) Location: 1/4, 1/4, Sec. 11 N13W			
5 miles South of Soso (distance) (direction) (Nearest Town)	Chalk down		
(3) Topography: (Hilly) (Flat) (Level)	to 95'		95'
(4) Purpose of Well: Home (Domestic Irrigation Municipal, Industrial, Other)	Next 15' fine sand.		15'
Information upon completion of well:			
(1) Diameter 2" inches.	Med Course		8 1/2'
(2) Total Depth 118 1/2 feet.			
(3) Water Level 75' feet below top of ground. 112 1/2' 2"			
(4) Cased to _____, Size _____			
(5) Screen: Size 1/4", Length 16'			
(6) Were any formations sealed against pollution? _____ yes, <input checked="" type="checkbox"/> no.			
If YES depth of formation _____			
Why _____			
Drillers Remarks: _____			

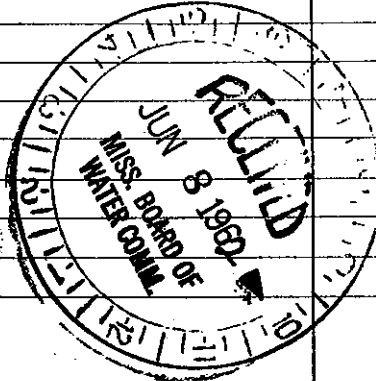

(Use Back Side)

Well No.

Mail this copy to Board of Water Commissioners 429 Miss. St. Jackson, Miss