

JONES MISSISSIPPI BOARD OF WATER COMMISSIONERS

A **E8**
12-14-63 **WATER WELL DRILLERS LOG**

Date: 12-14, 1963, Driller: H. J. Moxey County Jones
(Name)

| (1) Owner of Land: | Description & Color of Materials Sand, Clay, Red Clay, Shell, etc. | Thick- ness Feet | Depth Feet |
|---|---|------------------------|---------------|
| <u>C. O. Halfield</u> <small>(Name)</small> | <u>Chalk to</u> | | <u>19'</u> |
| <u>Soso, Miss</u> <small>(Address)</small> | <u>Hard rock to</u> | | <u>21'</u> |
| (2) Location: <u>R13W T8N 10</u> <small>1/4, 1/4, Sec. T R</small> | <u>Coursey sand from</u> | | |
| <u>5</u> miles <u>South</u> of <u>Soso</u> <small>(distance) (direction) (Nearest Town)</small> | <u>21' to 27'</u> | | |
| (3) Topography: <u>Level</u> <small>(Hilly) (Flat) (Level)</small> | <u>last 9' med.</u> | | |
| (4) Purpose of Well: <u>Home</u> <small>(Domestic Irrigation Municipal, Industrial, Other)</small> | <u>Coursey sand</u> | | |


Information upon completion of well:

- (1) Diameter 2 inches.
- (2) Total Depth 47 feet.
- (3) Water Level 20' feet below top of ground.
- (4) Cased to _____, Size _____
- (5) Screen: Size 1 1/4, Length 3'
- (6) Were any formations sealed against pollution?
 yes, no.

If YES depth of formation _____

Why _____

Drillers Remarks: _____

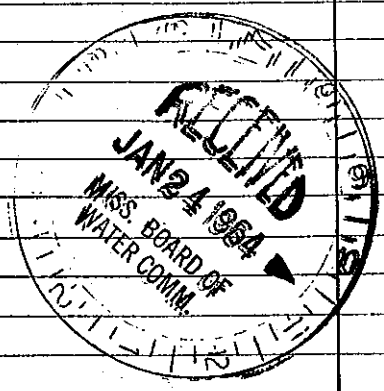

(Use Back Side)

Well No.