

JONES

MISSISSIPPI BOARD OF WATER COMMISSIONERS

E 12

WATER WELL DRILLERS LOG

2-19-62

Date 2-19, 1962, Driller H. J. Mosey County Jones

(Name)

(1) Owner of Land: <i>Ray Jiferate</i> <small>(Name)</small>	Description & Color of Materials Sand, Clay, Red Clay, Shell, etc.	Thick- ness Feet	Depth Feet
<i>Route #1 Leno, Miss</i> <small>(Address)</small>			
(2) Location: $\frac{1}{4}$ , $\frac{1}{4}$ , Sec. <i>6</i> T. <i>8</i> R. <i>13</i> W. <i>15</i> miles <i>West</i> of <i>Leno</i> <small>(distance) (direction) (Nearest Town)</small>			
(3) Topography: <i>None</i> <small>(Hills) (Flat) (Level)</small>			
(4) Purpose of Well: <i>Home</i> <small>(Domestic Irrigation Municipal, Industrial, Other)</small>			

*Clay & Chalk  
to 80' then  
10' very fine  
sand. Just  
1 1/2" good sand.*

Information upon completion of well:

(1) Diameter *2"* inches.

(2) Total Depth *91 1/2'* feet.

(3) Water Level *45'* feet below top of ground.

(4) Cased to \_\_\_\_\_, Size \_\_\_\_\_


(5) Screen: Size *1 1/4"*, Length *6'*

(6) Were any formations sealed against pollution?  
\_\_\_\_\_ yes, — no.

If YES depth of formation \_\_\_\_\_

Why \_\_\_\_\_

Drillers Remarks: \_\_\_\_\_

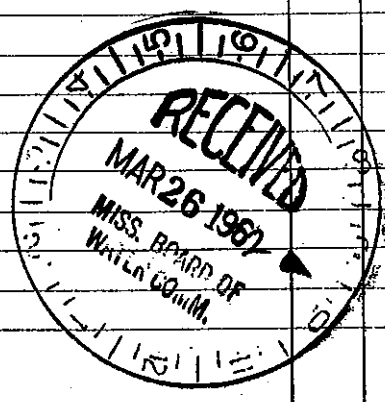

Well No.

(Use Back Side)

Mail this copy to Board of Water Commissioners 429 Miss. St. Jackson, Miss