

~~COLUMBIA~~
E 15 (6)

WATER BOARD

WATER WELL DRILLERS LOG

JONES

Date: 7-21-62, 1962, Driller: Harmon Parker County Cummins
(Name)

(1) Owner of Land: W. J. Ishee
(Name)
Rt. 2 Collins
(Address)

(2) Location: 9 1/4, 11 1/4, Sec. 11 T. 8 N. R. 14 W.
9 miles East, of Collins
(distance) (direction) (Nearest Town)

(3) Topography: Hilly
(Hilly) (Flat) (Level)

(4) Purpose of Well: Domestic
(Domestic Irrigation
Municipal, Industrial, Other)

Description & Color of Materials Sand, Clay, Red Clay, Shell, etc.	Thick- ness Feet	Dept Feet
<u>red Clay</u>	<u>41</u>	<u>41</u>
<u>Chalk</u>	<u>47</u>	<u>88</u>
<u>Sand</u>	<u>27</u>	<u>115</u>

Information upon completion of well:

(1) Diameter 2 inches.

(2) Total Depth 115 feet.

(3) Water Level 63 feet below top of ground.

(4) Cased to 115, Size 2"


(5) Screen: Size 2", Length 5'

(6) Were any formations sealed against pollution?
_____ yes, _____ no.

If YES depth of formation _____

Why _____

Drillers Remarks: _____

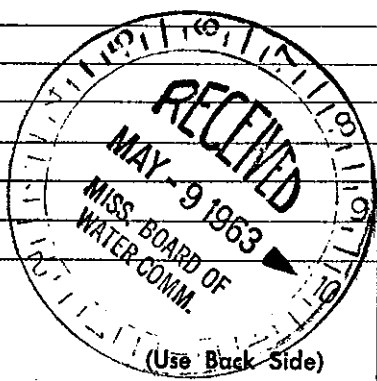

115
49 Well No.

Mail this copy to Board of Water Commissioners 429 Miss. St. Jackson, Miss