

Jones
E 28
6-2-62

MISSISSIPPI BOARD OF WATER COMMISSIONERS

WATER WELL DRILLERS LOG

Canal
7/1/1980

Date: 6/2, 1962, Driller: E. J. Clark
(Name)

CODED



		Description & Color of Materials Sand, Clay, Red Clay, Shell, etc.	Thick- ness Feet	Depth Feet
(1) Owner of Land: <u>Dale Thrush</u> (Name)		<u>0-5 Clay red</u>	<u>5</u>	
<u>Rt #1 Soso Miss</u> (Address)		<u>5-25 Sand</u>	<u>20</u>	
(2) Location: <u>17</u> <u>8 1/2</u> <u>3</u> <u>15</u> miles <u>West</u> of <u>Lumb</u> (distance) (direction) (Nearest Town)	<u>17</u> <u>8 1/2</u> <u>3</u> T R	<u>25-40 Clay</u>	<u>15</u>	
(3) Topography: <input checked="" type="checkbox"/> (Hilly) <input type="checkbox"/> (Flat) <input type="checkbox"/> (Level)		<u>40-59 Sand</u>	<u>19</u>	
(4) Purpose of Well: (Domestic, Irrigation, Municipal, Industrial, Other)				

Information upon completion of well:

- (1) Diameter 2 inches.
- (2) Total Depth 59 feet.
- (3) Water Level 41 feet below top of ground.
- (4) Cased to 53, Size 2
- (5) Screen: Size 1 1/4, Length 6
- (6) Were any formations sealed against pollution?
 yes, no.

CODED

If YES depth of formation
Why
Drillers Remarks:

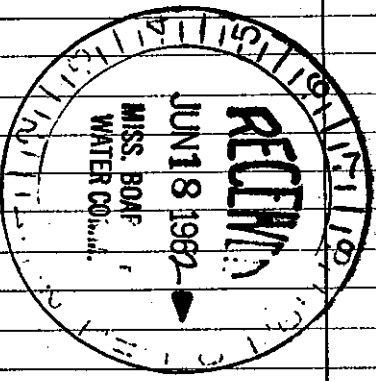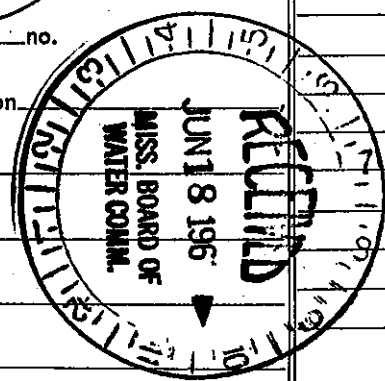

(Use Back Side)

Well No.

Mail this copy to Board of Water Commissioners 429 Miss. St. Jackson, Miss.