

JAN-4-2002 02:57P FROM:

TO:16013600535

P:4

State Well Report

Part 1

Mississippi Department of Environmental Quality
 Office of Land and Water Resources
 P.O. Box 10631
 Jackson, MS 39289-0631
 (601)961-5210
 (601)354-6938 (fax)

County: Jones
 Permit #: _____
 Driller: Travis Boone
 Date drilling completed: 2-22-08

For Office Use Only:
 Aquifer: _____
 Well #: L-63
 L. S. Elevation: _____
 E-log #: _____

State Law requires that this report be prepared by the driller in detail and filed with the Department within 30 days of completion of drilling of the well.

| Well Owner Information | Well Location |
|--|---|
| Owner Name: <u>James M. Mulloy</u> | Latitude: _____ Longitude: _____ |
| Mailing Address: <u>94 Dale Keep Rd</u> <u>Ellisville, MS</u> <u>39437</u> | Method of Lat/Long (circle one): <input type="radio"/> Conventional Survey, <input type="radio"/> USGS quad, <input type="radio"/> Hand-held GPS, <input type="radio"/> Survey-grade GPS |
| City: _____ State: _____ Zip Code: _____ | <u>4</u> <u>4</u> Sec <u>12</u> Twn <u>8N</u> Rng <u>13W</u> |
| Telephone No. (_____) _____ | Distance: _____ Direction: _____ Nearest Town: _____ <u>5</u> Miles <u>S</u> of <u>Ellisville</u> |

Well Data

Purpose of Well (circle one): Home Industrial Public Supply Irrigation Fish Culture Other: _____

Date well drilling started: 2-22-08 Date well drilling completed: 2-22-08

If flowing, method of flow regulation: Valve _____ Other (describe): _____

Static Water Level: 140 feet above or below (circle one) land surface Date measured: 2-22-08

Method of Measurement (circle one): steel tape electric tape air line other: StringLine

Hole depth: _____ Well depth: 180 Well grouted to a depth of 10 feet

Type of grout (circle one): Cement Bentonite Mix

Casing length: 110 feet Casing diameter: 4 inches Type of casing: Sch 40

Screen length: 20 feet Screen diameter: 4 inches Type of screen: Sch 40

Screen slot size: 8 inches Setting depth: From 160 feet to 180 feet

Type of completion (circle all applicable): Gravel packed Underreamed Telescoped Open hole Natural Development
 Other (describe): _____

Top of lap pipe or reduction in casing: _____ feet. If telescoped or more than one screen, describe on back of page

Logs run (circle all applicable): No log run Electric Gamma Ray Density Sonic Neutron Other: _____

Name of organization running log(s): _____

I certify that the well was drilled, constructed, and completed in accordance with all applicable requirements of the Mississippi Department of Environmental Quality and/or the Mississippi Department of Health regulations and state laws.

Travis Boone 0-514
 Print Name of Water Well Contractor and License No.

Travis Boone
 Signature of Water Well Contractor

RECEIVED
 MAR 22 2008
 BY: OLWR

JAN-4-2002 02:57P FROM:


TD: 16013600535

P:6

E-63

If well telescopes please sketch below and show depth.

Ground Level

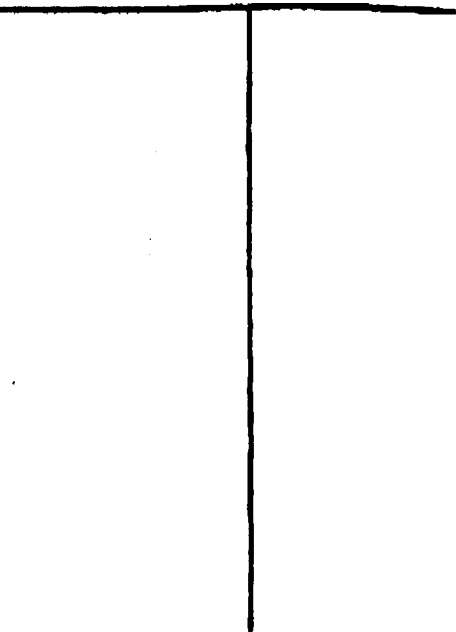

| Description of Formation Encountered | Feet | Ft |
|--------------------------------------|------|-----|
| Clay | 0 | 10 |
| sand | 10 | 150 |
| Clay | 30 | 50 |
| Rock | 80 | 85 |
| Clay | 85 | 100 |
| Rock | 100 | 105 |
| Clay | 105 | 140 |
| sand | 140 | 180 |
| | | |
| | | |
If more than one screen, show location of each on sketch

Sketch the property layout and include the following: 1) the well location; 2) any permanent structures on the property that may aid in locating the well; 3) any roads, power lines, or other items that may aid in locating the property and the well; 4) bearing direction.

Landowner Name: James Mulloy

Anna Boone
Signature of Well Well Contractor

RECEIVED
MAR 22 2008
BY: OLWR

JAN-4-2002 02:57P FROM:

TD:16013600535

P:5

STATE WELL REPORT

Part 2

Pump Installer's Completion Report
 Mississippi Department of Environmental Quality
 Office of Land and Water Resources
 P.O. Box 10091
 Jackson, MS 39209-0091
 (601)961-5210
 (601)954-6938 (fax)

For Office Use Only

Aplic:

Well #

Elevation:

Client: Jones
 Permit #: _____
 Diller: Travis Boone
 Date completed: 2-22-08

Aplic: _____
 Well #: E-63
 Elevation: _____

This report should be prepared by the pump installer in detail and filed with the Department within 30 days of the installation of pump.

| Well Owner Information | Well Location |
|--|--|
| Owner Name: <u>James Mulley</u> | Latitude: _____ Longitude: _____ |
| Mailing Address: <u>94 Dale Keys Rd</u> <u>Ellisville, Mo</u> | Method of Lat/Long (check one): Conventional Survey, USGS quad, Hand-held GPS, Survey-grade GPS |
| City: _____ State: <u>39437</u> Zip Code: _____ | USGS quad, Hand-held GPS, Survey-grade GPS <u>4</u> <u>12</u> <u>8N</u> <u>13W</u> |
| Telephone No. (_____) _____ | Distance _____ Direction _____ Nearest Town _____ <u>5</u> <u>5</u> <u>5</u> |

| Pump Type Circle one | Power Type Circle one |
|--|---|
| Air Lift <input type="checkbox"/> Jet <input checked="" type="checkbox"/> Submersible <input type="checkbox"/> | Diesel Engine <input type="checkbox"/> Gasoline Engine <input type="checkbox"/> Natural Gas <input type="checkbox"/> |
| Diaphragm <input type="checkbox"/> Plunger <input type="checkbox"/> Turbine <input type="checkbox"/> | Electric Motor <input checked="" type="checkbox"/> Hand <input type="checkbox"/> Tractor PTO <input type="checkbox"/> |
| Centrifugal <input type="checkbox"/> Rotary <input type="checkbox"/> Floating Well <input type="checkbox"/> | Windmill <input type="checkbox"/> Other (specify): _____ |
| Other (specify): _____ | Netto Power Rating of Motor: <u>3</u> |
| Date Pump Installed: <u>2-22-08</u> | Setting Depth: <u>175</u> feet |
| Rated Pump Capacity: <u>35</u> Gallons Per Minute | Number of Stages: _____ |

| Pump Test Data | Method of Measuring Water Level Circle one |
|--|--|
| Date Well Tested: <u>2-22-08</u> | Air Line <input type="checkbox"/> Electric Measuring Line <input type="checkbox"/> Steel Tape <input type="checkbox"/> |
| Static Water Level (A): <u>140</u> Feet Below Land Surface | Other (specify): <u>String Line</u> |
| Pumping Water Level (B): _____ Feet Below Land Surface | For flowing well, measured draw in leak: _____ feet |
| Drawdown (D) - (A): _____ Feet Below Land Surface | Well yielded _____ GPM with a drawdown of _____ feet after _____ hours of pumping |
| Test Pumping Rate: <u>45.0E</u> Gallons Per Minute | |
| Duration of Pump Test (minimum 4 hours): _____ hours | |

I HEREBY CERTIFY that the above statements are true to the best of my knowledge.

Travis Boone
 Field Representative and License No. (if applicable)

Travis Boone
 Signature of Pump Installer

RECEIVED
 MAR 22 2008
 BY: OLWR