

MISSISSIPPI BOARD OF WATER COMMISSIONERS

WATER WELL DRILLERS LOG

Found 7/1/69

CODED

60

12/28, 1960, Driller: C. P. Clark County Jones
(Name)


Owner of Land:	Description & Color of Materials Sand, Clay, Red Clay, Shell, etc.	Thick- ness Feet	Depth Feet
<u>Ollie Thrash</u> (Name)	<u>0-5 Sandy Clay</u>	<u>5</u>	
<u>#1 Soso Miss</u> (Address)	<u>5-69 Sandst</u>	<u>64</u>	
<u>17 8^N13^W</u>			
(2) Location: <u>1/4</u> , <u>1/4</u> , Sec. <u>T</u> <u>R</u> ,			
<u>3</u> miles <u>South</u> of <u>Big Creek</u> (distance) (direction) (Nearest Town)			
(3) Topography: (Hilly) (Flat) (Level)			
(4) Purpose of Well: <u>Domestic</u> (Domestic Irrigation Municipal, Industrial, Other)			

Information upon completion of well:

- (1) Diameter 2 inches.
- (2) Total Depth 69 feet.
- (3) Water Level 15 feet below top of ground.
- (4) Cased to 63, Size 2
- (5) Screen: Size 1/4, Length 6
- (6) Were any formations sealed against pollution?
no

If YES depth of formation _____
Why _____
Drillers Remarks: _____

CODED

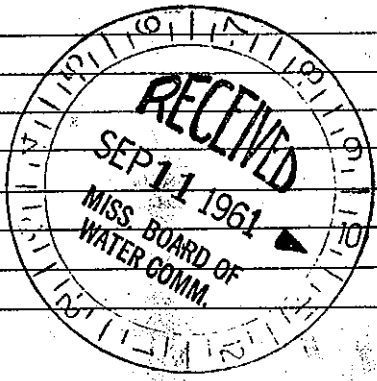

(Use Back Side)

Well No.