

JONES MISSISSIPPI BOARD OF WATER COMMISSIONERS

638 F12
7-18-61

WATER WELL DRILLERS LOG

7009?

Date: 7/18, 1961, Driller: C. J. Clark County: Jones
(Name)


(1) Owner of Land: Palmer Fails Court
(Name)
Rt # 5 Laurel Miss.
(Address)
(2) Location: 1/4, SE 1/4, Sec. 14, N 12th R 11W
2 miles South, of Laurel
(distance) (direction) (Nearest Town)
(3) Topography: Curve
(Hilly) (Flat) (Level)
(4) Purpose of Well: Domestic
(Domestic Irrigation Municipal, Industrial, Other)

Description & Color of Materials Sand, Clay, Red Clay, Shell, etc.	Thick- ness Feet	Depth Feet
0-8 Red Clay	08	
8-21 Sand	13	
21-54 Clay	33	
54-59 Sand	5	
59-62 Clay	3	
62-72 Sand	10	
72-115 Clay	43	
115-152 Sand	37	
152-170 Clay	18	
170-206 Sand	36	
206-216 Clay	36	
216-220 Rock	4	
220-240 Rock + Sand	20	
240-301 Clay + Sand	61	
301-363 Clay + Sand	62	
363-370 Muck + Sand	7	
370-390 Coarse Sand	20	

Information upon completion of well:

(1) Diameter 4 inches.
(2) Total Depth _____ feet.
(3) Water Level _____ feet below top of ground.
(4) Cased to _____, Size _____
(5) Screen: Size _____, Length _____
(6) Were any formations sealed against pollution?
_____ yes, _____ no.

If YES depth of formation _____
Why _____
Drillers Remarks: _____

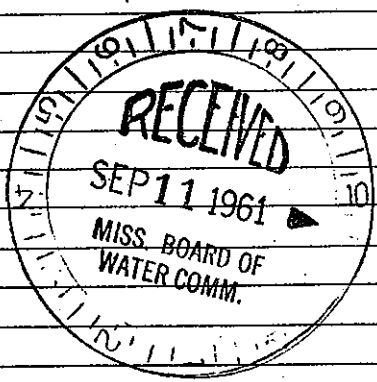

(Use Back Side)

Well No.

Mail this copy to Board of Water Commissioners 429 Miss. St. Jackson, Miss.