

3 F 19
7-21-65

WATER WELL DRILLERS LOG

of USGS
SOL
FR

Date: 7/20, 1966, Driller: C. J. Clark County Jones

(1) Owner of Land: City of Laurel
(Name)
Airbase South of Town
(Address)

(2) Location: 1/4, 1/4, Sec. 1 T. 1 R. 1
_____ miles _____ of _____
(distance) (direction) (Nearest Town)

(3) Topography: ✓
(Hilly) (Flat) (Level)

(4) Purpose of Well: Municipal
(Domestic Irrigation) (Municipal, Industrial, Other)

Description & Color of Materials Sand, Clay, Red Clay, Shell, etc.	Thick- ness Feet	Depth Feet
5-8 Clay	3	8
8-15 Sand	7	15
15-85 Clay	70	85
85-100 fine Sand	15	100
100-168 Sand	68	168
168-202 Sand	34	202
202-270 sandy Clay	68	270
270-288 Clay	18	288
288-310 Sand	12	300
310-340 Clay	30	330
340-352 Sand	12	342
352-390 mud	38	380
390-455 Sand	55	435
455-470 sandy Shale	15	450

Information upon completion of well:

(1) Diameter 2 inches.

(2) Total Depth 455 feet.

(3) Water Level 30 feet below top of ground.

(4) Cased to 445, Size 2


(5) Screen: Size 10, Length 1 1/4

(6) Were any formations sealed against pollution?
_____ yes, ✓ no.

If YES depth of formation _____

Why _____

Drillers Remarks: this was a test hole for making 20 in well

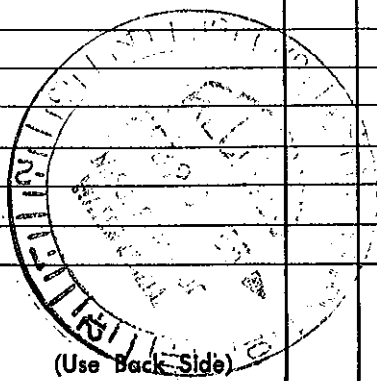

Well No.