


Date: 3/18, 1966, Driller: C.P. Clark County Jones  
 (Name)

(1) Owner of Land:	Description & Color of Materials Sand, Clay, Red Clay, Shell, etc.	Thick- ness Feet	Depth Feet
Callow Water case (Name) Pt # 7 Laurel, Miss (Address)	0-40 Sand	40	
(2) Location: NW 1/4, SE 1/4, Sec. 4, T4N R2W	40-55 Clay	15	
3 miles West of Laurel (distance) (direction) (Nearest Town)	55-119 Sand	64	
(3) Topography: Hilly (High) (Flat) (Low)	119-185 Clay	66	
(4) Purpose of Well: Community System (Domestic Irrigation, Municipal, Industrial, Other)	185-190 Sand	05	
	190-245 Clay	55	
	245-271 Sandy Clay	26	
	271-272 1/2 Hard rock	0 1/2	
	271 1/2-482 Sand	208 1/2	
	482-491 Mixed sand	09	

Information upon completion of well:

- (1) Diameter 6 inches.
- (2) Total Depth 482 feet.
- (3) Water Level 118 feet below top of ground.
- (4) Cased to 452, Size 6x4
- (5) Screen: Size 4in, Length 30
- (6) Were any formations sealed against pollution?  
 yes,  no.

If YES depth of formation 274  
 Why Sealed out upper water sands  
 Drillers Remarks:

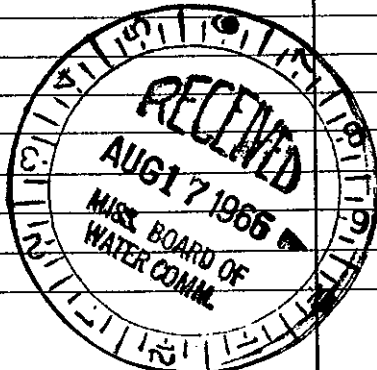

(Use Back Side)

Well No.