

JONES  
F 25

MISSISSIPPI BOARD OF WATER COMMISSIONERS

WATER WELL DRILLERS LOG

① 1-9-62

Date: 1/9, 1962, Driller: C.F. Clark County Jones

(Name)

(1) Owner of Land	Description & Color of Materials Sand, Clay, Red Clay, Shell, etc.	Thick- ness Feet	Depth Feet
A. H. Corley (Name)	0-20 red clay	20	
Rt # 1 Laurel Miss (Address)	20-45 sandy clay	25	
(2) Location: 1/4, 1/4, Sec. 7 T8 R12	45-79 white sand	54	
5 miles West of Laurel (distance) (direction) (Nearest Town)			
(3) Topography: Hill 20 (Hilly) (Flat) (Level)			
(4) Purpose of Well: Domestic (Domestic Irrigation Municipal, Industrial, Other)			


Information upon completion of well:

- (1) Diameter 2 inches.
- (2) Total Depth 99 feet.
- (3) Water level 52 feet below top of ground.
- (4) Cased to 94, Size 2 in
- (5) Screen: Size 1 1/4, Length 5
- (6) Were any formations sealed against pollution?  
yes, no.

If YES depth of formation

Why

Drillers Remarks:

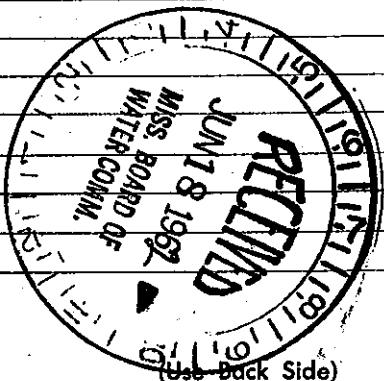

Well No.

Mail this copy to Board of Water Commissioners 429 Miss. St. Jackson, Miss.