

JONES

MISSISSIPPI BOARD OF WATER COMMISSIONERS

WATER WELL DRILLERS LOG

Date: March 12 1964, Driller: H. J. Maxey County Jones  
(Name)

	Description & Color of Materials Sand, Clay, Red Clay, Shell, etc.	Thick- ness Feet	Depth Feet
(1) Owner of Land: <u>J. L. Lovern</u> (Name)			
<u>Rt. 3, Ellisville, Miss.</u> (Address)			
(2) Location: <u>R13W T8N-15</u> <u>3 miles north, of Ellisville</u> (distance) (direction) (Nearest Town)	<u>Chalk down to</u>		<u>126'</u>
(3) Topography: <u>Level</u> (Hilly) (Flat) (Level)	<u>Fine Sand</u>		<u>156'</u>
(4) Purpose of Well: <u>Home</u> (Domestic Irrigation Municipal, Industrial, Other)	<u>Medicine Course</u>		<u>5'</u>


Information upon completion of well:

- (1) Diameter 2 inches.
- (2) Total Depth 161 feet.
- (3) Water Level 81 feet below top of ground.
- (4) Cased to 18', Size 4 in.
- (5) Screen: Size 1/4", Length 5 ft
- (6) Were any formations sealed against pollution?  
\_\_\_\_\_ yes, \_\_\_\_\_ no.

If YES depth of formation \_\_\_\_\_

Why \_\_\_\_\_

Drillers Remarks: \_\_\_\_\_

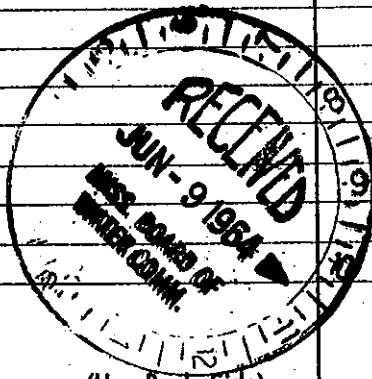

(Use Back Side)

Well No.

Mail this copy to Board of Water Commissioners 429 Miss. St. Jackson, Miss.