

JONES MISSISSIPPI BOARD OF WATER COMMISSIONERS

DF 30
6-22-64

WATER WELL DRILLERS LOG

Date: 6/22, 1964, Driller: C.P. Clark County Jones
(Name)


(1) Owner of Land:	Description & Color of Materials Sand, Clay, Red Clay, Shell, etc.	Thick- ness Feet	Depth Feet
<u>John Morgan</u> (Name) <u> Hwy 11 South of Laurel</u> (Address)	<u>0-5 yellow clay</u>	<u>05</u>	
(2) Location: <u>1/4</u> , <u>1/4</u> , Sec. <u>23</u> <u>T8 R18</u>	<u>5-18 sand</u>	<u>13</u>	
<u>1</u> miles <u>South</u> of <u>Laurel</u> (distance) (direction) (Nearest Town)	<u>18-88 Clay</u>	<u>70</u>	
(3) Topography: <u>Flat</u> (Hilly) (Flat) (Level)	<u>88-130 Clay Sandy S.</u>	<u>42</u>	
(4) Purpose of Well: <u>Industrial</u> (Domestic Irrigation Municipal, Industrial, Other)	<u>130-195 Sand</u>	<u>65</u>	
	<u>195-330 Clay</u>	<u>140</u>	
	<u>330-385 Sand</u>	<u>55</u>	
	<u>385-395 Mixed Sand</u>	<u>10</u>	
	<u>395-463 Sand</u>	<u>68</u>	

Information upon completion of well:

- (1) Diameter 4 inches.
- (2) Total Depth 463 feet.
- (3) Water Level 60 feet below top of ground.
- (4) Cased to 43, Size 4 in
- (5) Screen: Size 3 3/4, Length 20
- (6) Were any formations sealed against pollution?
 yes, no.

If YES depth of formation 325
Why Seal Surface Water

Drillers Remarks:

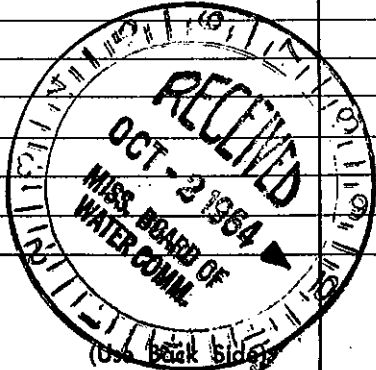

Well No.

Mail this copy to Board of Water Commissioners 429 Miss. St. Jackson, Miss.