

# STATE WELL REPORT

## Part 1

### Driller's Log

Mississippi Department of Environmental Quality  
Office of Land and Water Resources

P.O. Box 2309  
Jackson, MS 39225-2309  
(601)961-5210

(601)360-0535 (fax)

County: Jones  
 Permit #: \_\_\_\_\_  
 Driller: A-1 Drilling Serv. Inc.  
 Date drilling completed: 11-19-13

**For Office Use Only:**  
 Well #: F110  
 Aquifer: \_\_\_\_\_  
 E-Log #: \_\_\_\_\_

*State Law requires that this report be prepared by the license holder responsible for the work and filed with the Department at the above address within 30 days of completion of drilling of the well or borehole.*

Well Owner Information (Landowner if borehole is not for a water well)	Well or Borehole Location
Owner Name: <u>Bill Jenkins</u>	Latitude: <u>31° 39' 59" N</u> Longitude: <u>89° 10' 56" W</u>
Mailing Address: <u>676 Hwy 533</u>	Method of Lat/Long (check one): Conventional Survey _____
<u>Stanger Ms. 39481</u>	USGS quad _____, Hand-held GPS <input checked="" type="checkbox"/> , Survey-grade GPS _____
City State Zip Code	<u>NE 1/4 NE 1/4, Sec 15 T 8N R 12W</u>
Telephone No. <u>(601) 425-9004</u>	<u>1 1/2</u> Miles <u>SW</u> of <u>Laurel</u>
	(Distance) (Direction) (Nearest Town)

**Well / Borehole Data**

Date drilling started: 11-18-13 Date drilling completed: 11-19-13 Hole depth: 142 Hole diameter: 5 1/4

Location of the source of any surface water used for drilling: \_\_\_\_\_

Method of dosing and volume of Chlorine used in drilling and development: \_\_\_\_\_

Logs run (circle all applicable):  No log run  Electric  Gamma Ray  Density  Sonic  Neutron  Other: \_\_\_\_\_

Name of organization running log(s): \_\_\_\_\_

Purpose of borehole (circle one):  Water Well  Geotechnical/Geological Investigation  Ground Source Heat Pump  
 Seismic Survey  Other (describe) \_\_\_\_\_

*If drilling is not related to water well construction, skip the remainder of this block*

Purpose of Well (circle all applicable):  Home  Industrial  Public Supply  Irrigation  Fish Culture

Other (describe): \_\_\_\_\_

If a flowing well, method of flow regulation: Valve \_\_\_\_\_ Other (describe) \_\_\_\_\_

Static Water Level: 52' feet (above or  below land surface) Date measured: 11-20-13  
(circle one)

Method of measurement (circle one): Steel tape  Electric tape  Air line  Other (describe): Sonic

Well depth: 142' Well grouted to a depth of: 20 feet Type of grout (circle one):  Neat Cement  Bentonite Mix

Casing length: 122' feet Casing diameter: 4" inches Type of casing: PVC

Screen length: 20' feet Screen diameter: 4" inches Type of screen: Slotted PVC

Screen slot size: .006 inches Setting depth: From 122' feet to 142' feet

Type of completion (circle all applicable): Gravel packed  Underreamed  Open hole  Natural Development

Other (describe): \_\_\_\_\_

Top of lap pipe or reduction in casing: \_\_\_\_\_ feet

*If telescoped or more than one screen, describe on next page*


County: Jones  
 Permit #: \_\_\_\_\_

For Office Use Only:  
 Well #: F11C

The sketch below only required for water wells

If well telescopes, show depths on sketch.

Ground Level →

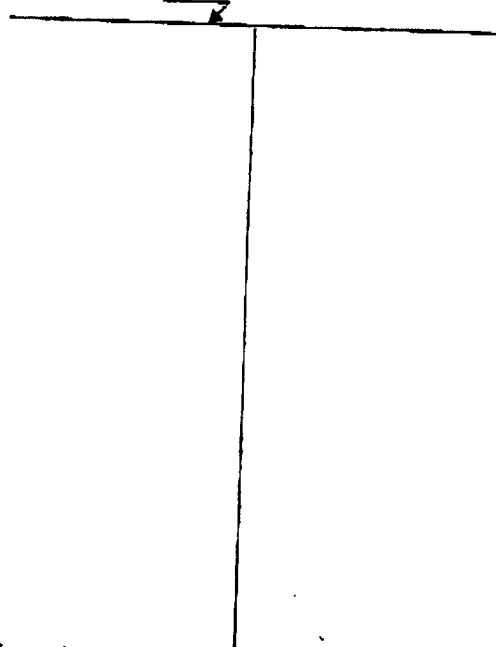


Description of formations encountered must be provided for all wells and boreholes, unless specifically exempted by regulations

Description of Formations Encountered	From (depth) To (depth)	
	Ground level	
Top Soil	0	1
Tan clay	1	11
Sand	11	17
Tan clay	17	23
Sandy clay	23	35
Sand	35	50
Clay	50	53
Sand	53	57
Green clay	57	110
Sand + clay mixed	110	120
Sand	120	142
Clay	142	

If more than one screen, show location of each on sketch

Sketch the property layout and include the following:

- 1) the well location
- 2) any permanent structures on the property that may aid in locating the well
- 3) any roads, power lines, or other items that may aid in locating the property and the well
- 4) north arrow

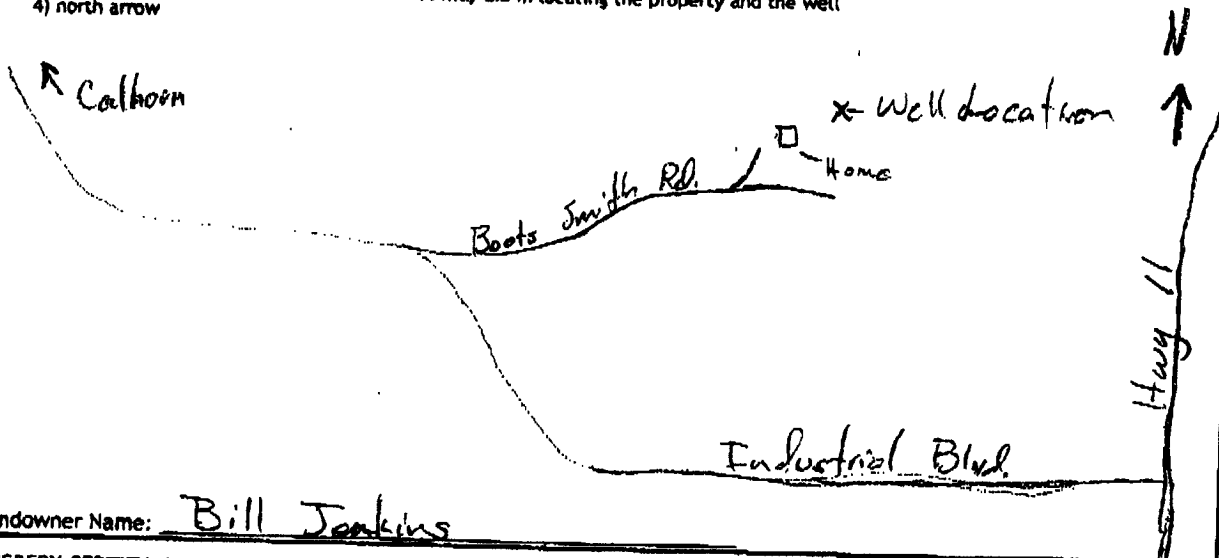

Landowner Name: Bill Jenkins

I HEREBY CERTIFY that the well/borehole was drilled, constructed, and completed in accordance with all applicable requirements of the Mississippi Department of Environmental Quality and the Mississippi Department of Health regulations, if applicable, and state laws.

Mike Baughman 587  
 Print Name of Responsible Licensee and License No.

11-21-13  
 Date

[Signature]  
 Signature of Licensee

# STATE WELL REPORT

## Part 2

**Pump Installer's Completion Report**  
 Mississippi Department of Environmental Quality  
 Office of Land and Water Resources  
 P.O. Box 2309  
 Jackson, MS 39225-2309  
 (601)961-5210  
 (601) 360-0535 (fax)

County: Jones  
 Permit #: \_\_\_\_\_  
 Driller: A-1 Drilling Serv. Inc.  
 Date completed: 11-19-13  
*Copy information from block on Part 1*

**For Office Use Only:**  
 Well #: F11C  
 Aquifer: \_\_\_\_\_

*This part of the report must be completed by a licensed water well contractor or a licensed pump installer. A copy of Part 1 of the report must be attached and both parts filed with the Department at the above address within 30 days of well completion.*

<b>Well Owner Information</b>		<b>Well Location</b>	
Owner Name: <u>Bill Jenkins</u>		Latitude: <u>31° 39' 59" N</u>	Longitude: <u>89° 10' 56" W</u>
Mailing Address: <u>676 Hwy 533</u>		Method of Lat/Long (check one): Conventional Survey _____	
<u>Stringer</u> <u>Ms.</u> <u>39981</u>		USGS quad _____, Hand-held GPS <input checked="" type="checkbox"/> , Survey-grade GPS _____	
City State Zip Code		<u>NE</u> ¼ <u>NE</u> ¼, Sec <u>15</u> T <u>8N</u> R <u>12W</u>	
Telephone No. <u>(601) 425 4004</u>		<u>1 1/2</u> Miles <u>SW</u> of <u>Laurel</u>	
		(Distance) (Direction) (Nearest Town)	

**Pump Type (circle one)**  
 Submersible Turbine Air Lift Centrifugal Flowing Well Jet Piston Rotary Other (describe): \_\_\_\_\_  
 Date Pump Installed: 11-20-13 Rated Pump Capacity: 55 Gallons Per Minute  
 Is This Pump (circle one):  NEW Repaired Replacement

**Power Type (circle one)**  
 Electric Diesel Gasoline Natural Gas Tractor PTO Windmill Other (describe): \_\_\_\_\_  
 Horse Power Rating of Motor: 5 Setting Depth: 100 feet Number of Stages: 15

**Pump Test Data for Non Flowing Well**  
 Date Well Tested: \_\_\_\_\_ Duration of Pump Test (minimum 4 hours): \_\_\_\_\_ hours  
 Static Water Level (A): 52 Feet Below Land Surface Pumping Water Level (B): \_\_\_\_\_ Feet Below Land Surface  
 Drawdown [(B) - (A)]: \_\_\_\_\_ Feet Below Land Surface Test Pumping Rate: \_\_\_\_\_ Gallons Per Minute  
 Method of measurement (circle one): Steel tape Electric tape Air line Other (describe): \_\_\_\_\_

**Pump Test Data for Flowing Well**  
 Measured shut in head: \_\_\_\_\_ feet.  
 Well yielded \_\_\_\_\_ GPM with a drawdown of \_\_\_\_\_ feet after \_\_\_\_\_ hours of pumping

**Meter Installation**  
 Meter Manufacturer: \_\_\_\_\_ Meter Serial Number: \_\_\_\_\_  
 Meter Model Number/Name: \_\_\_\_\_ Type of Meter: \_\_\_\_\_  
 Totalizer Register Unit and Multiplier Factor (AF x .001, gal x 1000, etc): \_\_\_\_\_  
 Installation Date: \_\_\_\_\_ Meter installed by: \_\_\_\_\_  
 Is This Meter (circle one): New Repaired Replacement

*Important: By submitting the above information you are certifying that this meter was installed to manufacturer standards. For agricultural wells, a list of approved meters is on the MDEQ website.*

I HEREBY CERTIFY that the above statements are true to the best of my knowledge.  
Mike Baughman 587 11-21-13 [Signature]  
 Print Name of Pump Installer and License No. (if applicable) Date Signature of Pump Installer