


JONES
 36741
 5-23-63

MISSISSIPPI BOARD OF WATER COMMISSIONERS

WATER WELL DRILLERS LOG

Date: 5/23, 1963, Driller: C.P. Clark County Jones
 (Name)

(1) Owner of Land:	Description & Color of Materials Sand, Clay, Red Clay, Shell, etc.	Thick- ness Feet	Depth Feet
<u>C.P. Clark</u> (Name)	<u>0-12 Grey Clay</u>	<u>12</u>	
(Address)	<u>12-21 White Sand</u>	<u>09</u>	
(2) Location: <u>NW 1/4, NE 1/4, Sec. 4, T8R11</u>	<u>21-24 Clay</u>	<u>3</u>	
<u>1</u> miles <u>East</u> of <u>Savel</u>	<u>24-31 Sand</u>	<u>13</u>	
(distance) (direction) (Nearest Town)	<u>31-58 Clay</u>	<u>21</u>	
(3) Topography: <input checked="" type="checkbox"/> (Hilly) <input type="checkbox"/> (Flat) <input type="checkbox"/> (Level)	<u>58-80 Sandy Clay</u>	<u>22</u>	
(4) Purpose of Well: <u>Industrial</u>	<u>80-100 Fine Sand</u>	<u>20</u>	
(Domestic Irrigation, Municipal, Industrial, Other)	<u>100-134 Coarse Sand</u>	<u>34</u>	
Information upon completion of well:	<u>134-148 Clay</u>	<u>14</u>	
(1) Diameter <u>5</u> inches.	<u>148-153 Sand</u>	<u>04</u>	
(2) Total Depth <u>318</u> feet.	<u>153-181 Clay</u>	<u>28</u>	
(3) Water Level _____ feet below top of ground.	<u>181-195 Sand</u>	<u>14</u>	
(4) Cased to <u>306</u> , Size <u>5 in</u>	<u>195-226 Clay</u>	<u>31</u>	
(5) Screen: Size <u>5 in</u> , Length <u>12 ft</u>	<u>226-318 Sand</u>	<u>92</u>	
(6) Were any formations sealed against pollution?			
<input checked="" type="checkbox"/> yes, _____ no.			
If YES depth of formation <u>220</u>			
Why <u>Seal Surface Water</u>			
Drillers Remarks:			

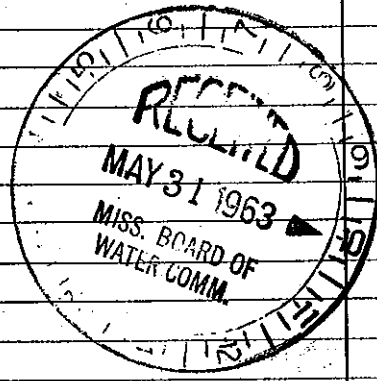

Well No.

(Use Back Side)