

JONES MISSISSIPPI BOARD OF WATER COMMISSIONERS

DG3
7-15-60

WATER WELL DRILLERS LOG

C. P. CLARK
WATER WELL DRILLING
ROUTE TWO
LAUREL, MISS.


Date: 1/15, 1960, Driller: _____ County: Jones

(1) Owner of Land: <u>Carl Strickland</u> (Name)	Description & Color of Materials Sand, Clay, Red Clay, Shell, etc.	Thick- ness Feet	Depth Feet
<u>Pt #6 Laurel Miss.</u> (Address)	<u>0-15 Clay</u>	<u>15</u>	
(2) Location: <u>1/4, 1/4, Sec. 7, T. 21 N., R. 11 E.</u>	<u>15-36 fine Sand</u>	<u>21</u>	
<u>3 miles East of Laurel</u> (distance) (direction) (Nearest Town)	<u>21-140 blue Clay</u>	<u>119</u>	
(3) Topography: <u>on right of Hwy 84</u> (Hilly) (Flat) (Level)	<u>119-150 mixed Clay Sand</u>	<u>29</u>	
(4) Purpose of Well: <u>Domestic</u> (Domestic Irrigation Municipal, Industrial, Other)	<u>150-190 grey Sand</u>	<u>40</u>	
	<u>190-320 blue Clay</u>	<u>130</u>	
	<u>320-363 Sand</u>	<u>43</u>	
	<u>363-370 fine Sand</u>	<u>07</u>	

Information upon completion of well:

- (1) Diameter 2 inches.
- (2) Total Depth 310 feet.
- (3) Water Level 163 feet below top of ground.
- (4) Cased to 353, Size 2
- (5) Screen: Size 1/4, Length 10
- (6) Were any formations sealed against pollution?
 yes, no.

If YES depth of formation 195 ft
Why To stop red water from above fine sand
Drillers Remarks: _____

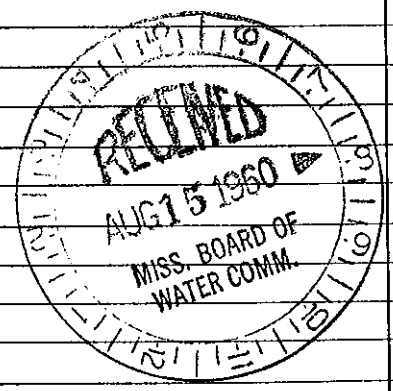

(Use Back Side)

Well No.