

JONES

MISSISSIPPI BOARD OF WATER COMMISSIONERS

DG 46 8
6-18-62

WATER WELL DRILLERS LOG

Date: 6/18, 1962, Driller: C.P. Clark County Jones
(Name)

(1) Owner of Land:	Description & Color of Materials Sand, Clay, Red Clay, Shell, etc.	Thick- ness Feet	Depth Feet
Powers School (Name) Rt #6 Laurel Miss	0-50 Clay	50	
(Address)	50-55 Sand	05	
(2) Location: NE 1/4, NE 1/4, Sec. 3 28N R11W	55-100 Sandy Clay	45	
3 East Laurel	100-145 Sand	45	
(distance) (direction) (Nearest Town)	145-155 Blue Clay	10	
(3) Topography: -	155-200 Grey Sand	45	
(Hilly) (Flat) (Level)	200-245 Blue Clay	45	
(4) Purpose of Well: School	245-257 Sandy Clay	12	
(Domestic Irrigation Municipal, Industrial, Other)	257-308 Blue Sand	51	
	308-310 Clay	02	


Information upon completion of well:

- (1) Diameter 4 inches.
- (2) Total Depth 309 feet.
- (3) Water Level 90 feet below top of ground.
- (4) Cased to 299, Size 4
- (5) Screen: Size 3, Length 10
- (6) Were any formations sealed against pollution?
yes, no. 240

If YES depth of formation

Why

Drillers Remarks:

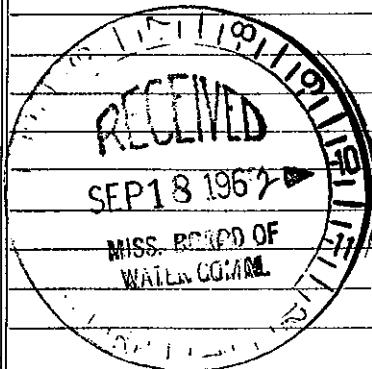

(Use Back Side)

Well No.

Mail this copy to Board of Water Commissioners 429 Miss. St. Jackson, Miss.