

JONES MISSISSIPPI BOARD OF WATER COMMISSIONERS

6 G 23
7-16-60

WATER WELL DRILLERS LOG

WATER WELL DRILLING

Date: 7/16, 1960, Driller: LAUREL MISS. County Jones

(1) Owner of Land: <u>Charles Blackwell</u> (Name) <u>Rt #6 Laurel Miss</u> (Address)	Description & Color of Materials Sand, Clay, Red Clay, Shell, etc.	Thick- ness Feet	Depth Feet
(2) Location: $\frac{1}{4}$, $\frac{1}{4}$, Sec. <u>3</u> <u>R 11</u> <u>3</u> miles <u>East</u> of <u>Laurel</u> (distance) (direction) (Nearest Town)	<u>0-10 Clay</u>	<u>10</u>	
(3) Topography: <input checked="" type="checkbox"/> (Hilly) <input type="checkbox"/> (Flat) <input type="checkbox"/> (Level)	<u>10-23 fine Sand</u>	<u>13</u>	
(4) Purpose of Well: <u>Chicken Houses</u> (Domestic Irrigation Municipal, Industrial, Other)	<u>23-170 Clay</u>	<u>147</u>	
	<u>170-270 Grey Sand</u>	<u>50</u>	


Information upon completion of well:

- (1) Diameter 2 1/2 inches.
- (2) Total Depth 210 feet.
- (3) Water Level 125 feet below top of ground.
- (4) Cased to 200, Size 2 1/2
- (5) Screen: Size 2 in, Length 10
- (6) Were any formations sealed against pollution?
 yes, no.

If YES depth of formation Cutoff fine Sand

Why _____

Drillers Remarks: 3rd Right
Past Eastview Church
1/2 mile South

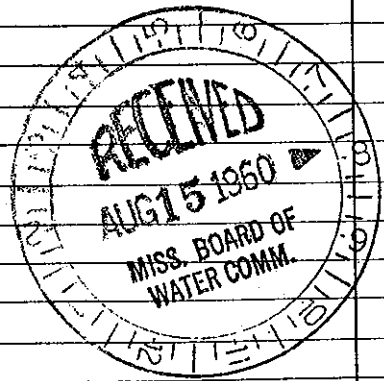

(Use Back Side)

Well No.