

JONES  
G<sup>26</sup>

WATER WELL DRILLERS LOG

WATER WELL DRILLING  
ROUTE TWO  
LAUREL, MISS.

Date: 8-24-60, Driller: \_\_\_\_\_ County Jones

(1) Owner of Land: Charles Kitchens  
(Name)

Rt #1 Laurel Miss  
(Address)

(2) Location: 1/4, 34 T<sup>8N</sup> R11W

6 miles South of Laurel  
(distance) (direction) (Nearest Town)

(3) Topography: Level  
(Hilly) (Flat) (Level)

(4) Purpose of Well: Domestic  
(Domestic Irrigation  
Municipal, Industrial, Other)

Description & Color of Materials Sand, Clay, Red Clay, Shell, etc.	Thick- ness Feet	Depth Feet
<u>0-90 Clay</u>	<u>90</u>	
<u>90-115 Sand</u>	<u>25</u>	
<u>115-260 Clay</u>	<u>145</u>	
<u>260-301 Sand</u>	<u>41</u>	

Information upon completion of well:

(1) Diameter 2 inches.

(2) Total Depth 301 feet.

(3) Water Level 50 feet below top of ground.

(4) Cased to 291, Size 2 in


(5) Screen: Size 1 1/4, Length 10

(6) Were any formations sealed against pollution?  
no

If YES depth of formation \_\_\_\_\_

Why \_\_\_\_\_

Drillers Remarks:  Hwy 15 South  
6 Miles in Tubers  
Crossing Community

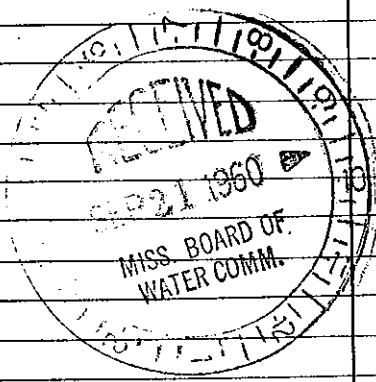

(Use Back Side)

Well No.

Mail this copy to Board of Water Commissioners 429 Miss. St. Jackson, Miss