

JONES

MISSISSIPPI BOARD OF WATER COMMISSIONERS

6 G 27
8-30-60

WATER WELL DRILLERS LOG

C. P. CLARK

Date: 8/30, 1960, Driller: WATER WELL DRILLING County: Jones

ROUTE TWO
LAUREL, MISS.

(1) Owner of Land: J. C. Felt
Rt # 4 Laurel, Miss
(Name)
(Address)

(2) Location: 1/4, 1/4, Sec. 16, T. 11, R. 11, N
1 miles South of Laurel
(distance) (direction) (Nearest Town)

(3) Topography: Hilly, Flat, Level
Hilly 15, South

(4) Purpose of Well: Domestic Irrigation, Municipal, Industrial, Other

Description & Color of Materials Sand, Clay, Red Clay, Shell, etc.	Thick- ness Feet	Depth Feet
0-90 Clay	90	
90-110 fine Sand	20	
110-150 Clay	40	
150-195 Sand	45	
195-220 Clay	25	
220-250 Sand	30	
250-472 Clay	222	
472-486 Sand	14	
486-497 Rock	11	

Information upon completion of well:

(1) Diameter 2 inches.

(2) Total Depth 486 feet.

(3) Water Level 90 feet below top of ground.

(4) Cased to 476, Size 2 in


(5) Screen: Size 1 1/4, Length 10

(6) Were any formations sealed against pollution?
yes, no.

If YES depth of formation

Why

Drillers Remarks:

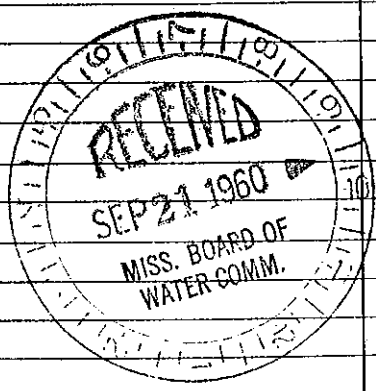

(Use Back Side)

Well No.