

**JONES** MISSISSIPPI BOARD OF WATER COMMISSIONERS

5 G 30

**WATER WELL DRILLERS LOG**

10-17-60

C. F. CLARK  
WATER WELL DRILLING  
ROUTE TWO  
LAUREL, MISS.

Date: 10/17, 1960, Driller: \_\_\_\_\_ County: Jones

		Description & Color of Materials Sand, Clay, Red Clay, Shell, etc.	Thick- ness Feet	Depth Feet
(1) Owner of Land: <u>Frank Stone</u> (Name) <u>Rt #1 Laurel Miss.</u> (Address)		<u>0-90 Clay</u>	<u>90</u>	
(2) Location: _____ 1/4, _____ 1/4, Sec. <u>3</u> <sup>8N</sup> <u>R. 11</u> <u>1 1/2</u> miles <u>East</u> , of <u>Laurel</u> (distance) (direction) (Nearest Town)		<u>90-100 Sand</u>	<u>10</u>	
(3) Topography: <input checked="" type="checkbox"/> (Hilly) <input type="checkbox"/> (Flat) <input type="checkbox"/> (Level)		<u>100-170 Clay</u>	<u>70</u>	
(4) Purpose of Well: <u>Domestic</u> (Domestic Irrigation, Municipal, Industrial, Other)		<u>170-210 Sand</u>	<u>40</u>	
		<u>210-260 Clay</u>	<u>50</u>	
		<u>260-300 Sand</u>	<u>40</u>	
		<u>300-334 Sandy Silt</u>	<u>34</u>	
		<u>334-345 Sand</u>	<u>11</u>	


Information upon completion of well:

- (1) Diameter 2 inches.
- (2) Total Depth 345 feet.
- (3) Water Level 91 feet below top of ground.
- (4) Cased to 335, Size 2 in.
- (5) Screen: Size 1/4, Length 10ft.
- (6) Were any formations sealed against pollution?  
\_\_\_\_\_ yes,  no.

If YES depth of formation \_\_\_\_\_

Why \_\_\_\_\_

Drillers Remarks: 1 1/2 miles East on Laurel, Myrick Road, on left by Brick home

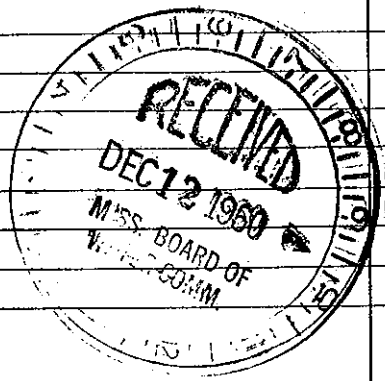

(Use Back Side)

Well No. \_\_\_\_\_