

JONES MISSISSIPPI BOARD OF WATER COMMISSIONERS

G 31
10-18-60

WATER WELL DRILLERS LOG

WATER WELL DRILLING
ROUTE TWO

Date: 10/18, 1960, Driller: LAUREL MISS. County Jones

		Description & Color of Materials Sand, Clay, Red Clay, Shell, etc.	Thick- ness Feet	Depth Feet
(1) Owner of Land: <u>Russell Crane Jr.</u> (Name)				
<u>Rt #4 Laurel Miss</u> (Address)				
(2) Location: <u>1/4, 1/4, Sec. 15 T. 8N. R. 11W</u>				
<u>2 1/2</u> miles <u>SE</u> of <u>Laurel</u> (distance) (direction) (Nearest Town)				
(3) Topography: <input checked="" type="checkbox"/> (Hilly) <input type="checkbox"/> (Flat) <input type="checkbox"/> (Level)				
(4) Purpose of Well: <u>Domestic</u> (Domestic Irrigation Municipal, Industrial, Other)				
		<u>0-90 Clay</u>	<u>90</u>	
		<u>90-100 Sandy Clay</u>	<u>10</u>	
		<u>100-180 Clay</u>	<u>80</u>	
		<u>180-205 Sand</u>	<u>25</u>	


Information upon completion of well:

- (1) Diameter 2 inches.
- (2) Total Depth 205 feet.
- (3) Water Level 110 feet below top of ground.
- (4) Cased to 195, Size 2
- (5) Screen: Size 1 1/4, Length 10ft
- (6) Were any formations sealed against pollution?
no

If YES depth of formation _____

Why _____

Drillers Remarks: 2 1/2 miles South in Glade Community

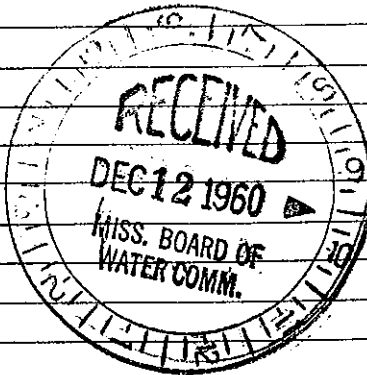

(Use Back Side)

Well No.