

MISSISSIPPI BOARD OF WATER COMMISSIONERS

WATER WELL DRILLERS LOG

JONES
LG 33

11-24-60

Date: Nov 24, 1960, Driller: H.H. Baker County Jones
(Name)

(1) Owner of Land: B.D. Dickerson
(Name)
Lanul Miss
(Address)

(2) Location: 1/4, 1/4, Sec. 27 T8N R11W
3 miles South of Lanul
(distance) (direction) (Nearest Town)

(3) Topography: (Hilly) (Flat) (Level)

(4) Purpose of Well: Home
(Domestic Irrigation, Municipal, Industrial, Other)

Description & Color of Materials Sand, Clay, Red Clay, Shell, etc.	Thick- ness Feet	Depth Feet
<u>Red sandy clay</u>	<u>60</u>	
<u>Gray</u>	<u>30</u>	
<u>White</u>	<u>25</u>	
<u>Blue</u>	<u>90</u>	
<u>Red</u>	<u>15</u>	
<u>sand</u>	<u>21</u>	
		<u>241 ft</u>

Information upon completion of well:

(1) Diameter 2 inches.

(2) Total Depth 241 feet.

(3) Water Level 105 feet below top of ground.

(4) Cased to 229, Size 2"


(5) Screen: Size 1/4, Length 12

(6) Were any formations sealed against pollution?
no

If YES depth of formation _____

Why _____

Drillers Remarks: _____

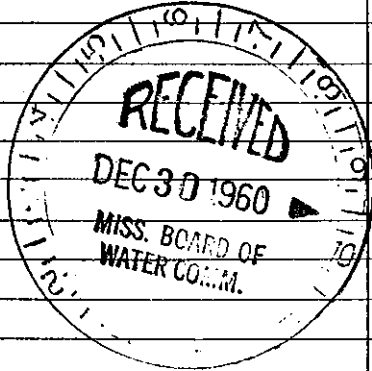

(Use Back Side)

Well No.

Retain this copy for your office files.