

JONES MISSISSIPPI BOARD OF WATER COMMISSIONERS

5 G 35
12-1-60

WATER WELL DRILLERS LOG

C. P. CLARK

Date: 12/1, 1960, Driller: WATER WELL DRILLING County Jones

ROUTE TWO
LAUREL, MISS.

(1) Owner of Land: A.B. Yelverton
(Name)
Rt #4 Laurel Miss
(Address)

(2) Location: 1/4, 1/4, Sec. 16 T. 8 N. R. 11 E
2 miles South of Laurel
(distance) (direction) (Nearest Town)

(3) Topography: (Hilly) (Flat) (Level)

(4) Purpose of Well: Domestic
(Domestic Irrigation, Municipal, Industrial, Other)

Description & Color of Materials Sand, Clay, Red Clay, Shell, etc.	Thick- ness Feet	Depth Feet
<u>0-90 Clay</u>	<u>90</u>	
<u>90-110 Sandy Clay</u>	<u>20</u>	
<u>110-170 Clay</u>	<u>60</u>	
<u>170-215 Sand</u>	<u>45</u>	
<u>215-431 Clay</u>	<u>216</u>	
<u>431-451 Sand</u>	<u>20</u>	

Information upon completion of well:

(1) Diameter 2 inches.

(2) Total Depth 451 feet.

(3) Water Level 94 feet below top of ground.


(4) Cased to 441, Size 2

(5) Screen: Size 1 1/2, Length 10

(6) Were any formations sealed against pollution?
no

If YES depth of formation _____
Why _____

Drillers Remarks: Hwy 15
South 2 miles from
city limits on
left of road

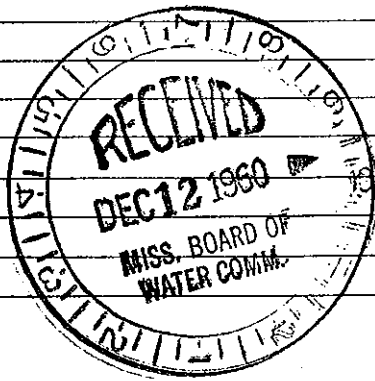

(Use Back Side)

Well No.